


UNITED STATES
DEPARTMENT OF THE INTERIOR
BUREAU OF LAND MANAGEMENT

SECTION SE SW
Sec. 19

Oregon State Water Filings

TOWNSHIP 20^s, RANGE 43^E, W. M.

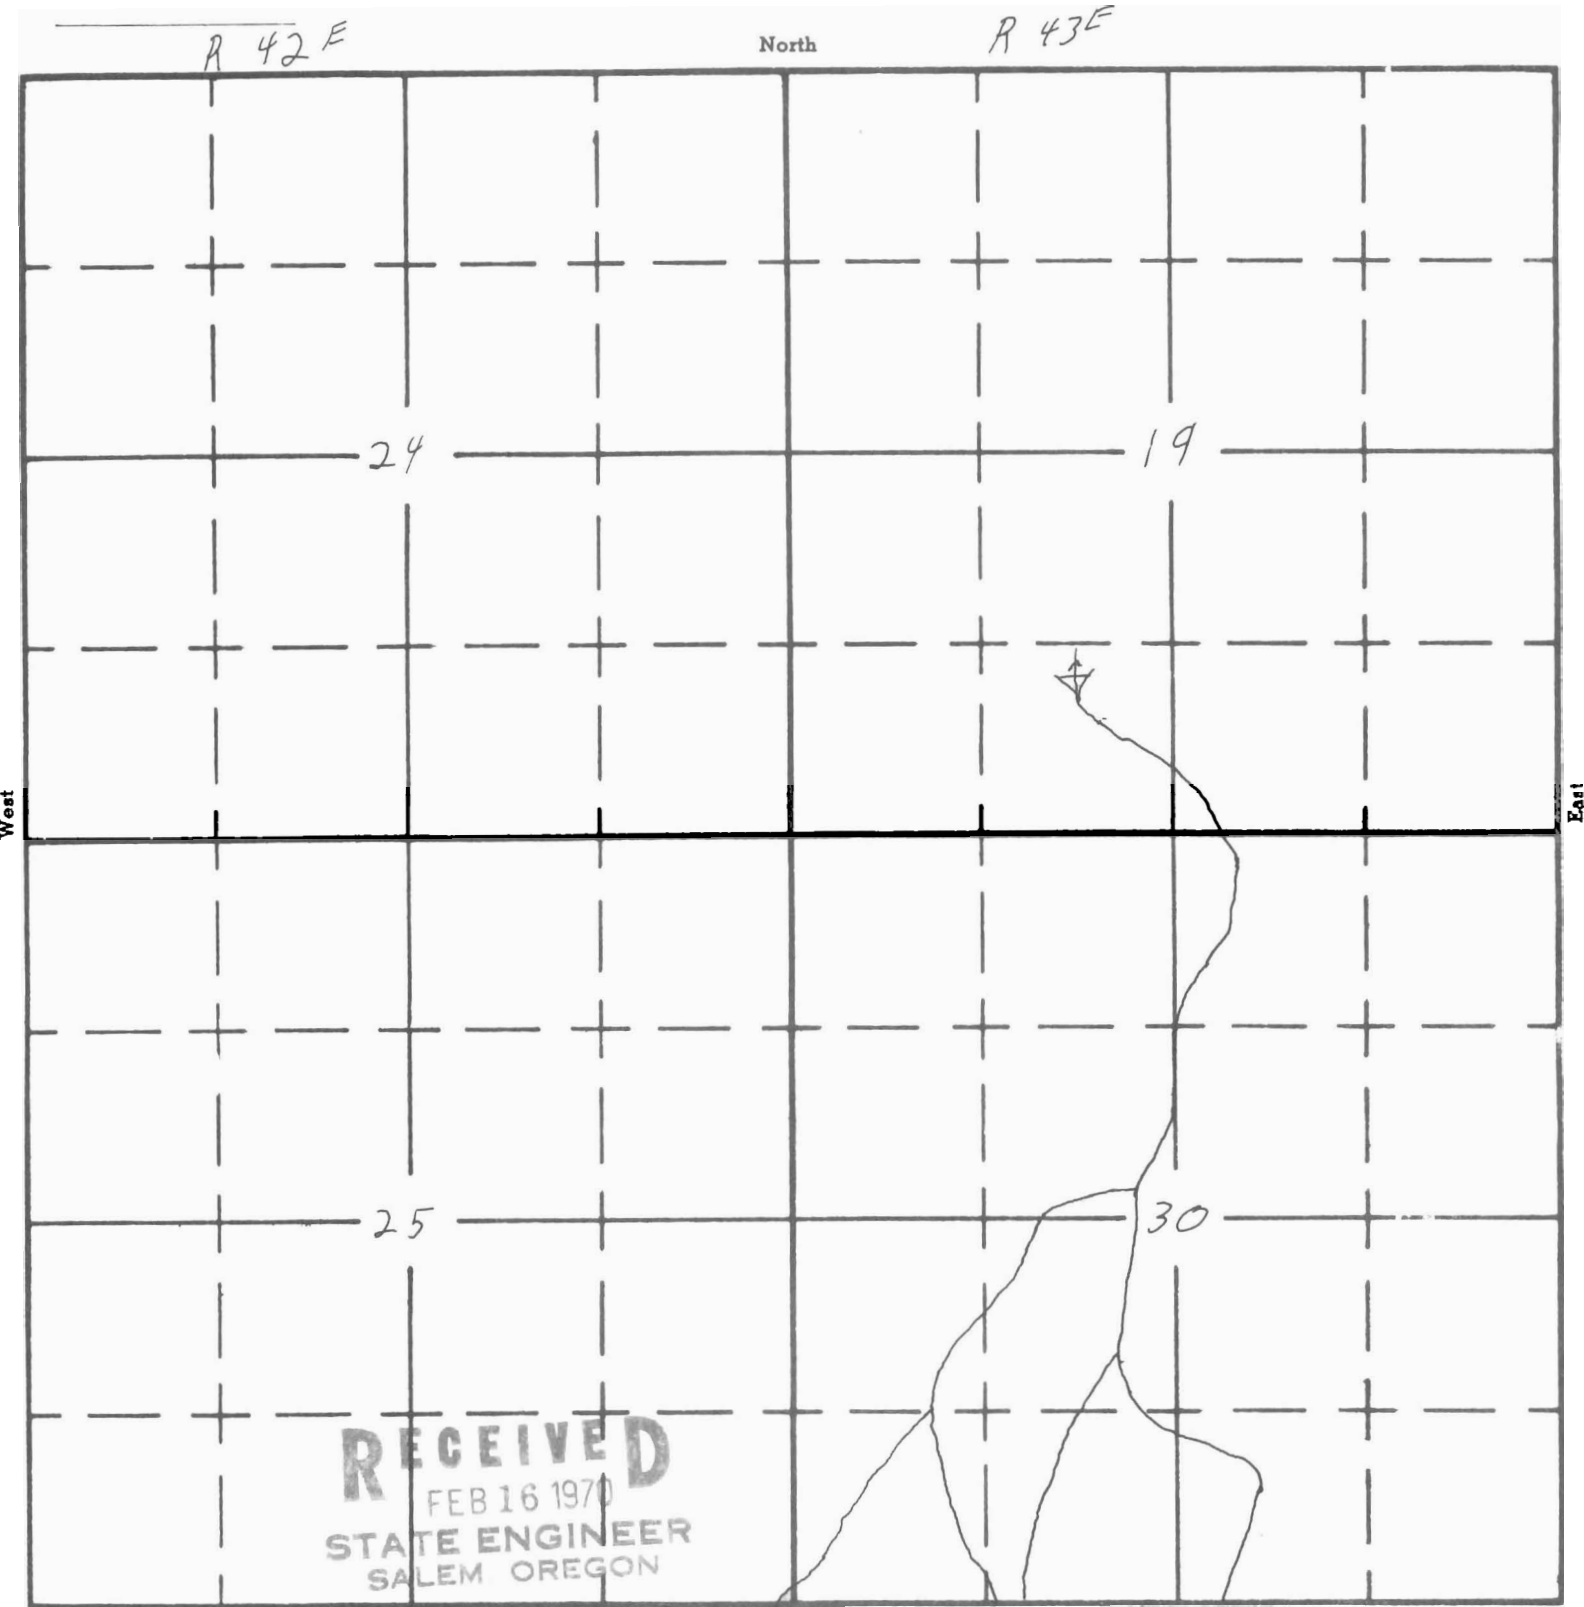

RECEIVED
FEB 16 1970
STATE ENGINEER
SALEM OREGON

Davy Crickett

APPLICATION No. 4673
PERMIT No. 5652