


T.14S.,R.14E.,W.M.

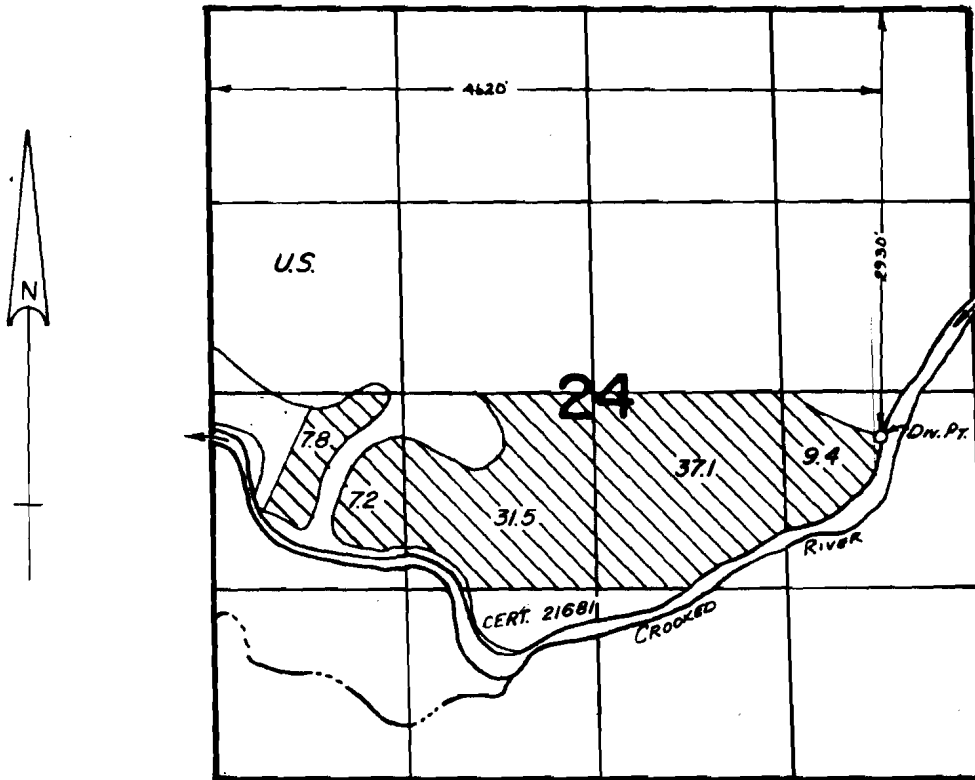

SCALE: 1" = 1320'

FINAL PROOF SURVEY
UNDER

Transfer No. 3743
Application No. Permit No.
IN NAME OF

.....**RAFTER Q. CATTLE CO.**.....

Surveyed JULY...27, 1979., by L.H. MUNN.....

10868
52181
73743

9561

Compton Prop. 11/25/1979