


T. 26S., R. 3W., W.M.

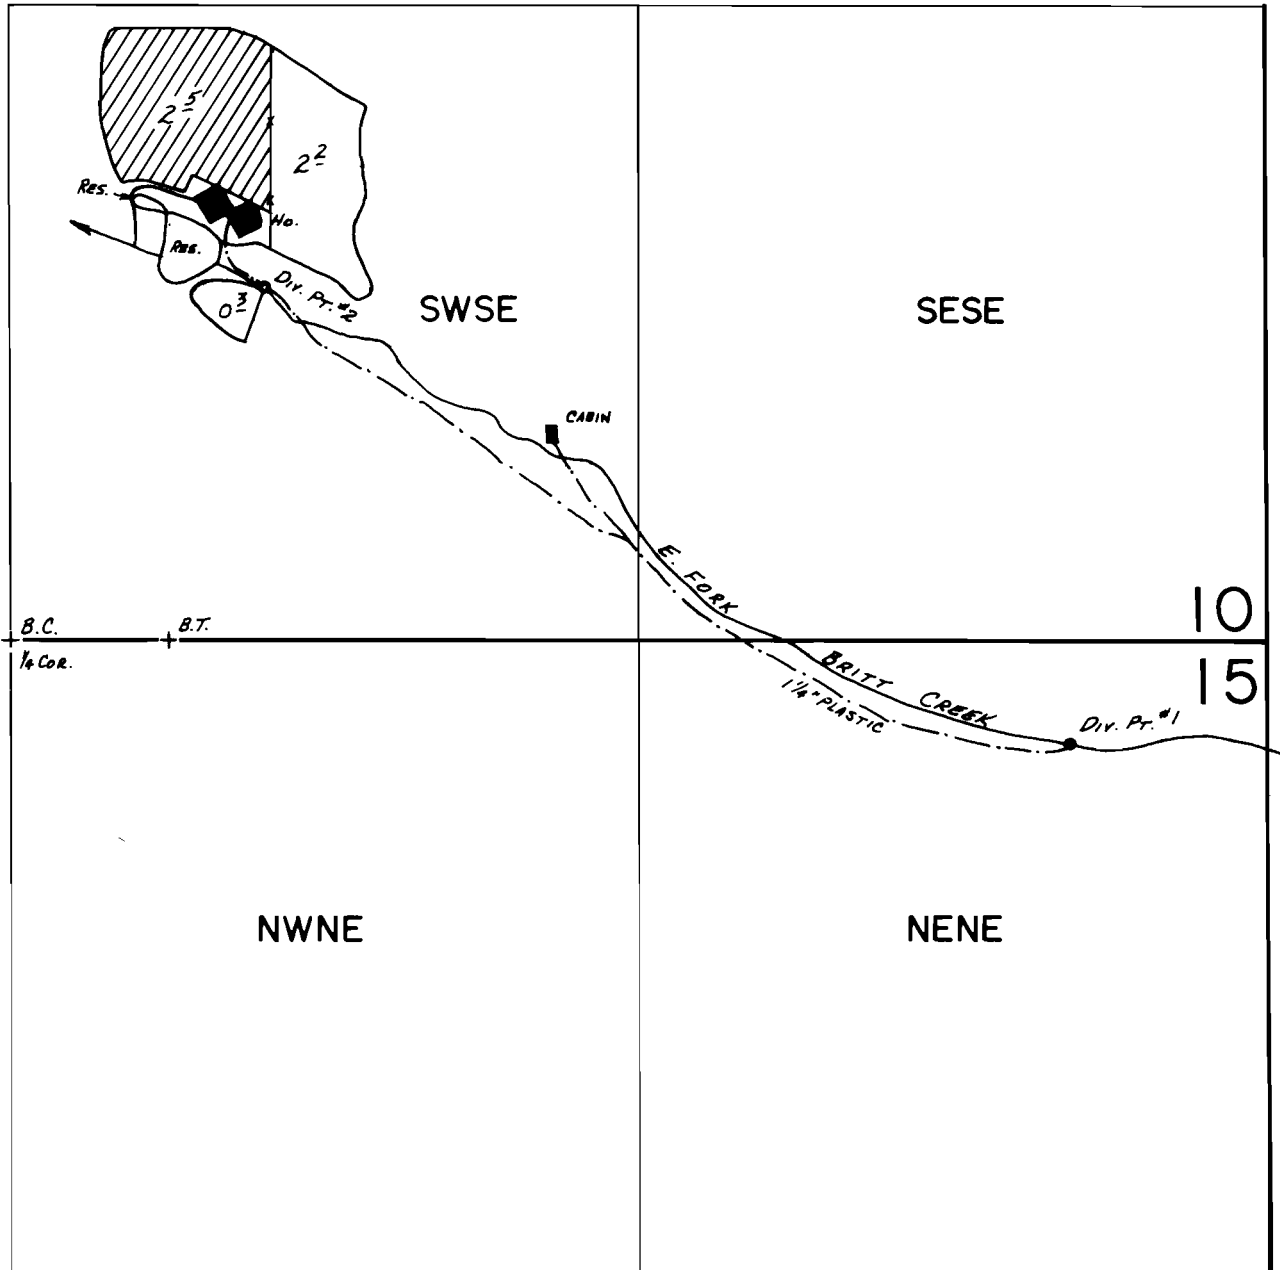

DIV. PTS. LOC.: #1- 210 S. & 2200 E.; #2- 730 N. & 530 E., BOTH FROM S. 1/4 COR. SEC. 10.

SCALE: 1" = 400'

FINAL PROOF SURVEY

UNDER

Application No. 45508... Permit No. 33736.....

IN NAME OF

ALAN B. KNUDTSON

Surveyed APR. 17, 1980, by J.S. DONALDSON