


T.23S. R.4W. W.M.

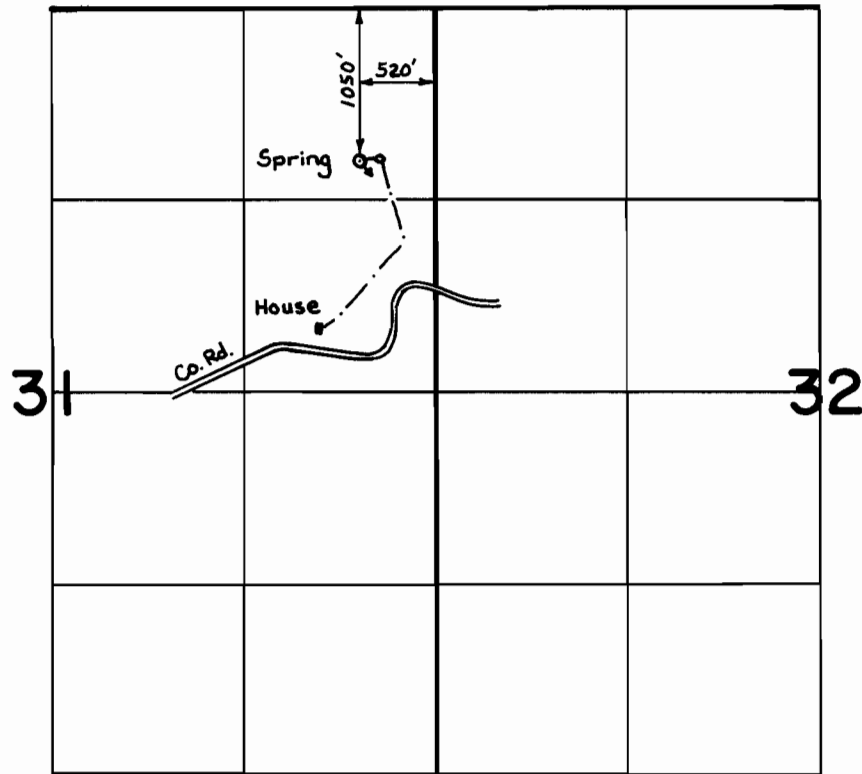

SCALE : 4" = 1 mile

FINAL PROOF SURVEY
UNDER

Application No. 55433 Permit No. 41816
IN NAME OF

Bill D. & Deborah L. Martindale

Surveyed Oct. 3, 1979, by S. Donaldson