


T.26S. R.3W. W.M.

Sec. 1

SW 1/4 NE 1/4

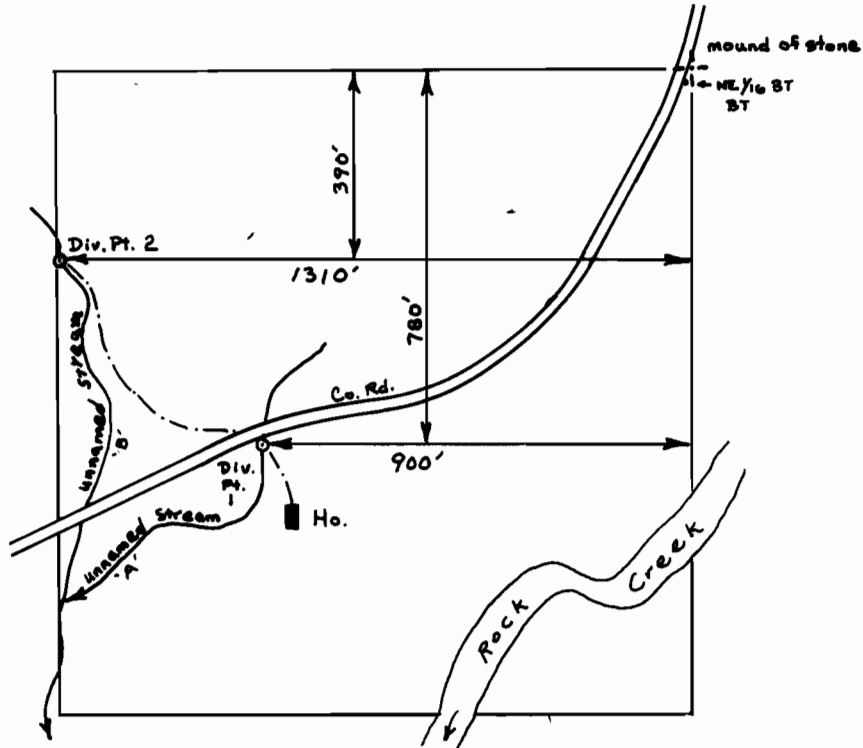

SCALE : 1" = 400'

FINAL PROOF SURVEY
UNDER

Application No. 56298 Permit No. 41964
IN NAME OF

ERNIE G. GILBERT

Surveyed July 5 1978, by D. Henry