


T. 31 S. R. 4 W. W.M.

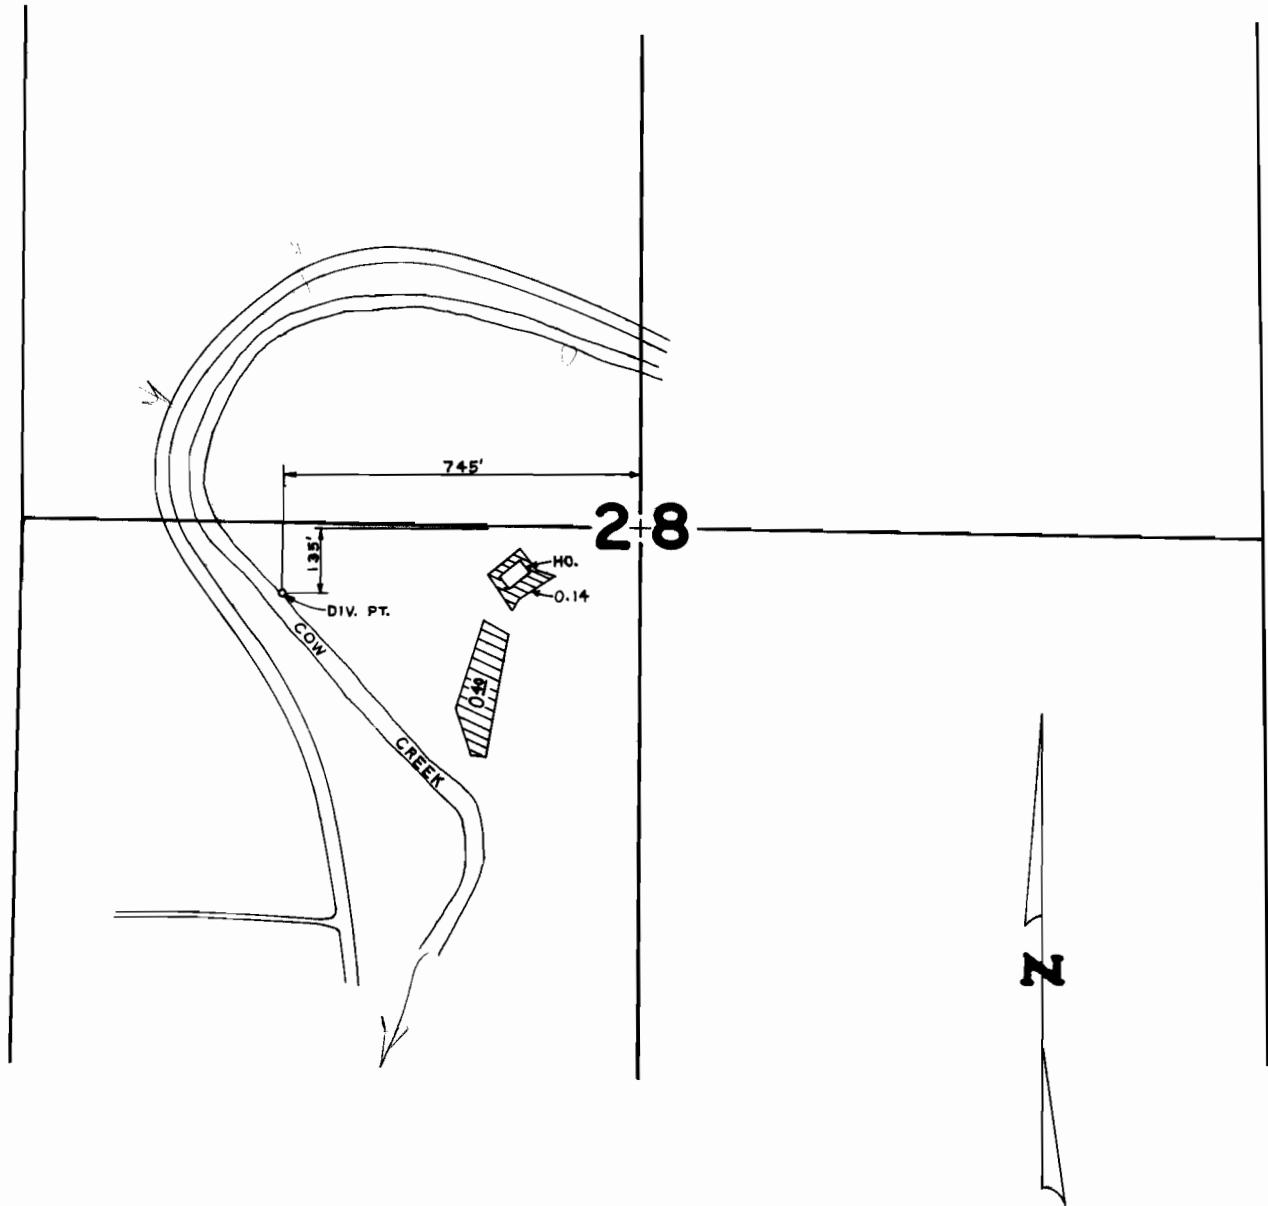

SCALE: 1" = 400'

FINAL PROOF SURVEY UNDER

Application No. 58920.. Permit No. 44439.....
IN NAME OF

.....DOUGLAS COUNTY.....

Surveyed FEB. 27, 1984, by ..L. CASHION..