
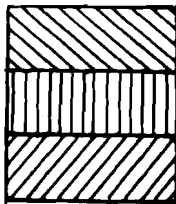


T.15S., R.12E., W.M.

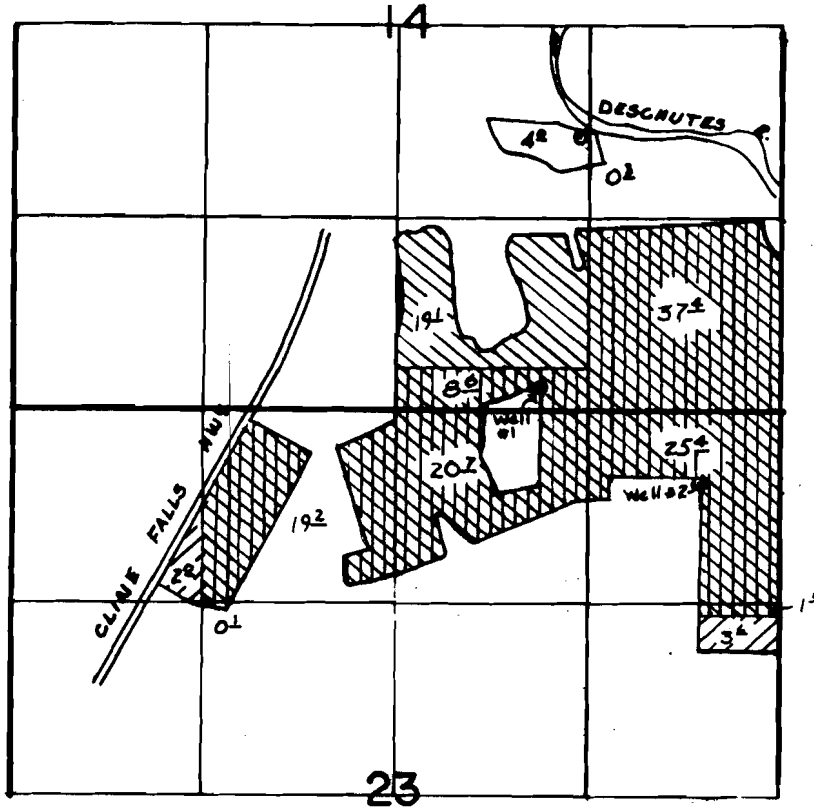

- G-6284 Primary Well #1
- G-9103 Supplemental Well #2
- G-9103 Primary Well #2

Well #1 is 150' N and 1640' W of the NE corner of Sec. 23

Well #2 is 500' S and 550' W of the NE corner of Sec. 23

SCALE: 4" = 1 mile



FINAL PROOF SURVEY UNDER

G-6764 G-6284 (COR. 52191)
 Application No. G-9932. Permit No. G-9103.... and. 52185
 IN NAME OF

FRANK N. & GEORGANNA CHASE

Surveyed MAY 14, 1983, by L.H. NUNN.....

9-6284
179-106 LEO