




35002

Sup 52192  
66222

T. 3N., R. 22E., W.M.

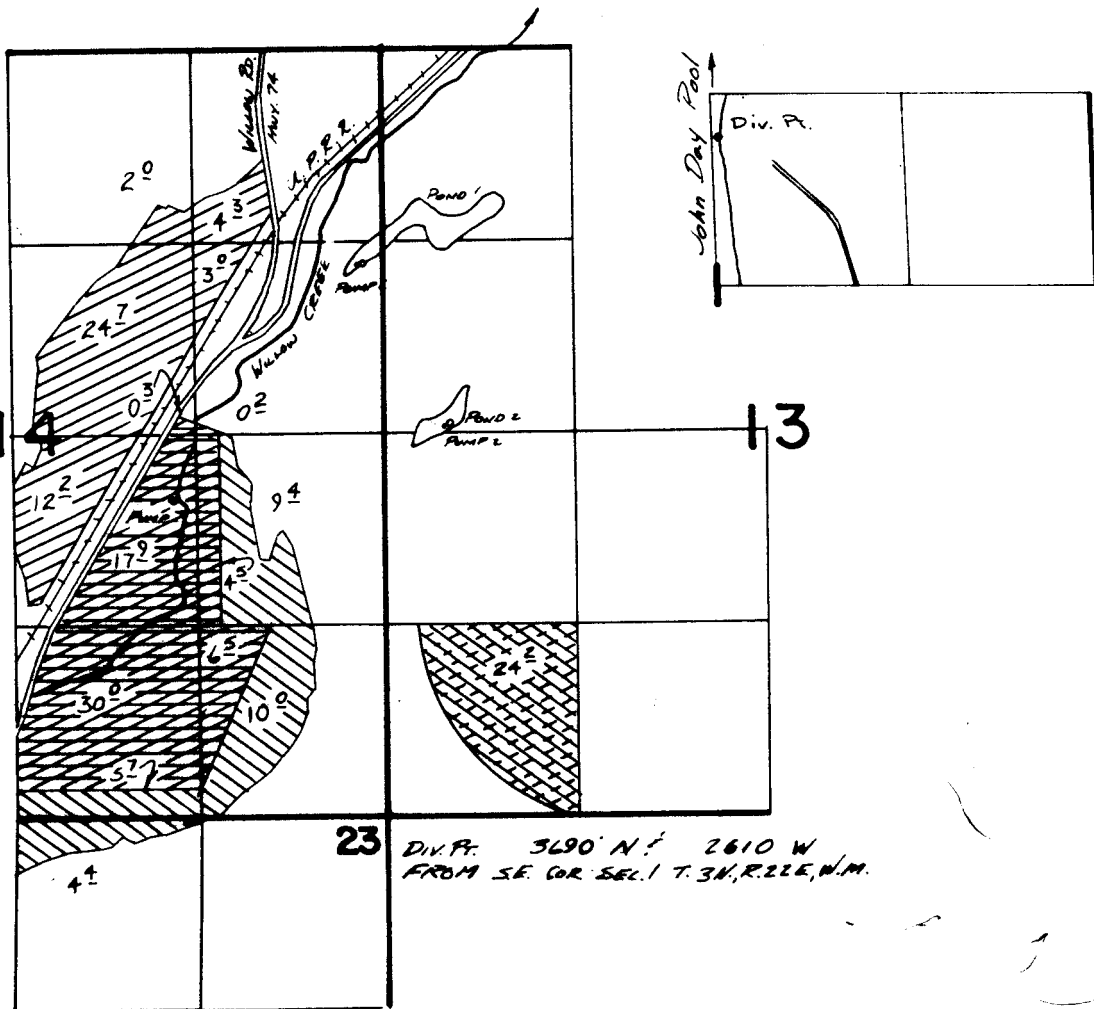

23 DIV. PT. 3690 N + 2610 W  
FROM SE. COR. SEC. 1 T. 3N., R. 22E., W.M.

	DAVIS SULLIVAN PRIMARY		DAVIS SCHRIMSHAR SUPPL
---	------------------------	---	------------------------

### FINAL PROOF SURVEY UNDER

Application No. 46806. Permit No. 35002.  
IN NAME OF

LeoAnna A. Schrimsher et al.

Surveyed APRIL 11 1974 by H. E. GRUND  
AUG. 25 82 V. L. CHURCH

1984  
MSP. DIV. PT. & DAVIS