


T. 6S., R. 6W., W.M.

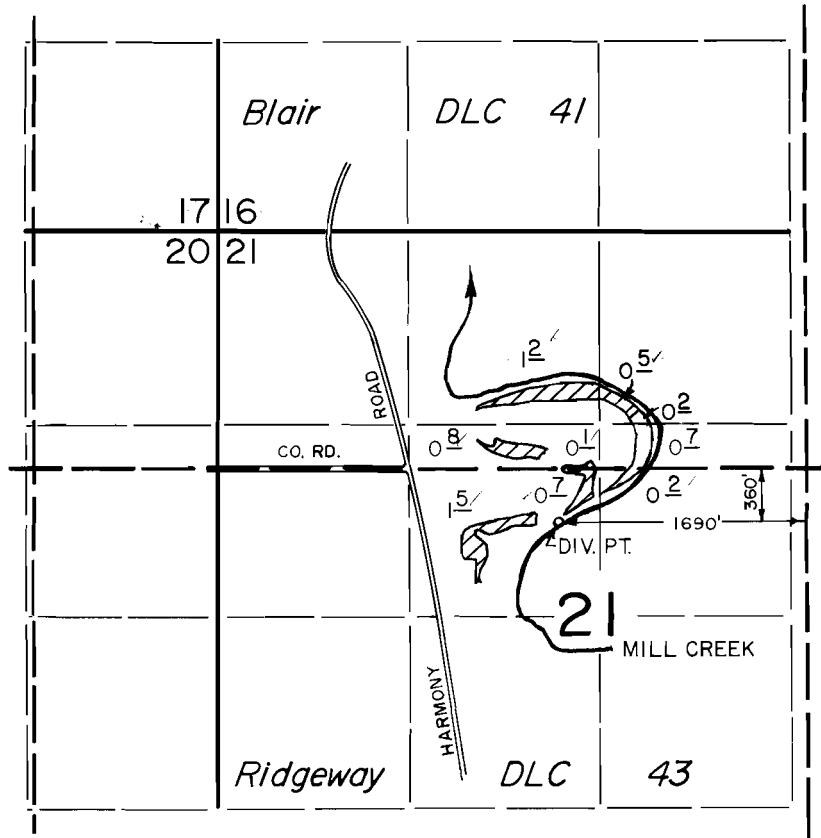

FINAL PROOF SURVEY UNDER

Application No. 53216... Permit No. 39490.....
IN NAME OF

...GEORGE J. & HERTA L. RIGGS.....

Surveyed JUNE 1..... 19.79., by R. G. MUCKEN.....