


T. 36 S., R. 3 W., W.M.

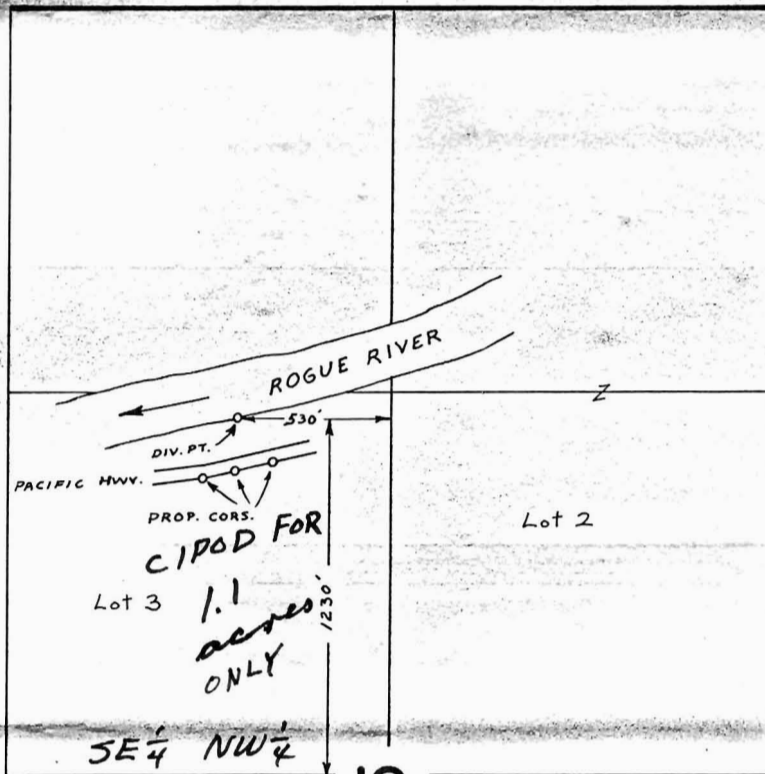

19

SCALE : 1" = 660 FT.

FINAL PROOF SURVEY UNDER

Transfer No. 3380 CIPOD
 Application No. 2898 Permit No. 1566
 IN NAME OF

EDWARD & PEARL KRUUSI

Surveyed SEPT. 20 1978 by B. SUND

Certificate No.
48668

Priority
4-22-13

Rogue River
Vol. 1