


T.39S. R.3W. W.M.

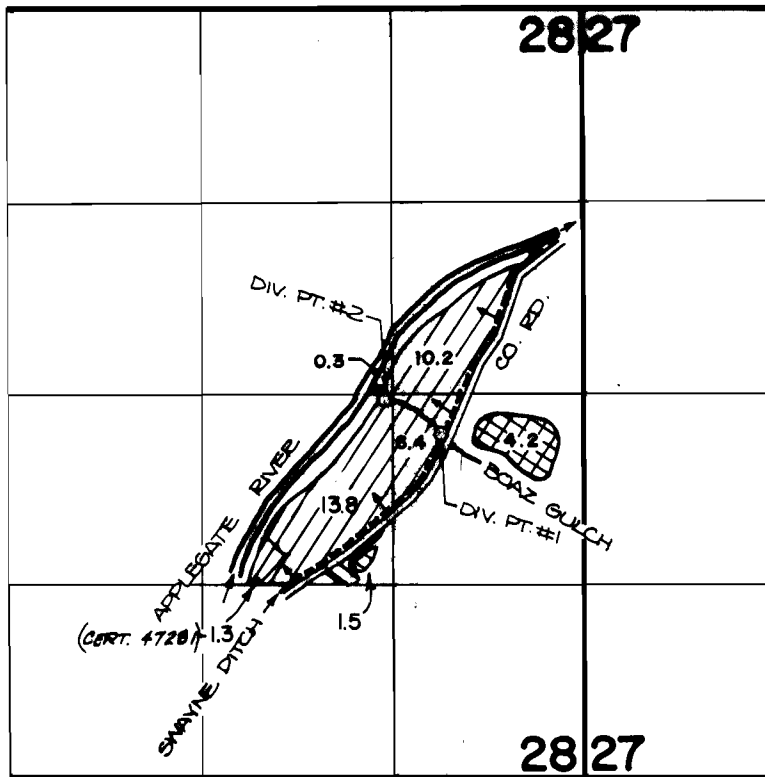

DIV. PT. #1 LOC: 290'S. AND 990'W.; DIV. PT. #2 LOC: 80'S. AND 1340'W.; BOTH FROM THE E1/4 CORNER OF SECTION 28.



TRANSFER NO. 4701



PERMIT NO. 42216

FINAL PROOF SURVEY
UNDER

TRANSFER NO. 4701

Application No. 55963 Permit No. 42216.....

IN NAME OF

JACK A. AND/OR HELEN HOFFBUHR

Surveyed MAY 6 1982, by B. SUND.....