


T.13S., R. 9E., W.M.  
Section 15

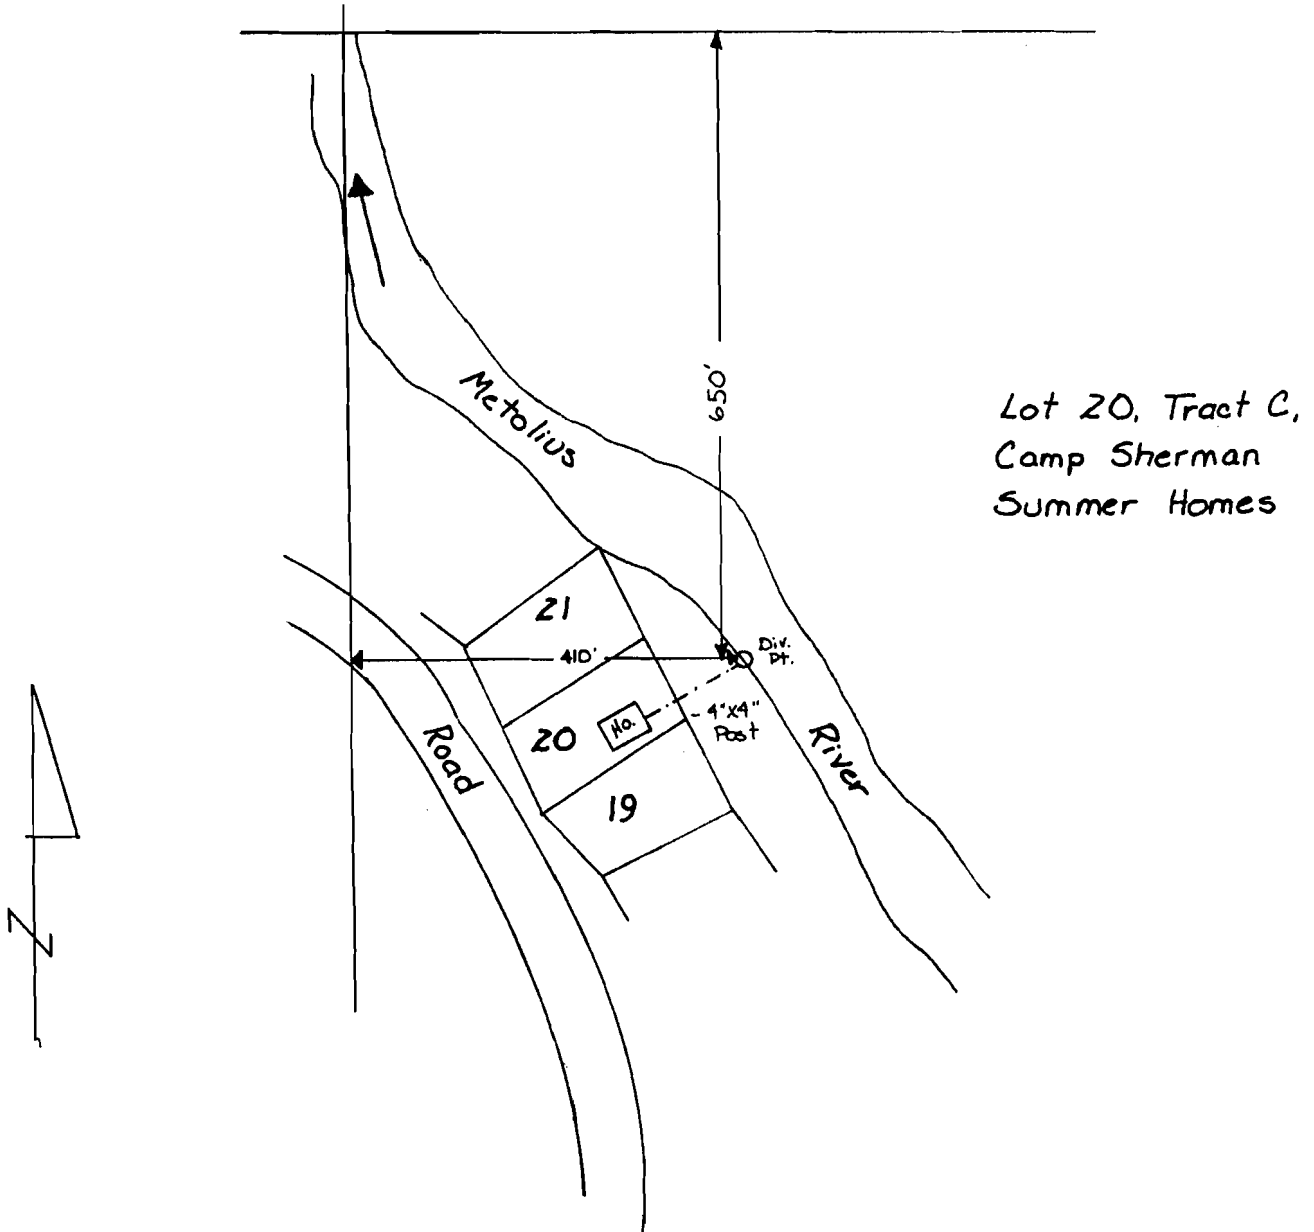

**FINAL PROOF SURVEY**

UNDER

Application No. 63587 Permit No. 47153 C. 52208

IN FAVOR OF

JACK A. WYNE

Surveyed OCT. 17, 1983, by B. ESTES