


T. 37S., R. 5 W., W.M.

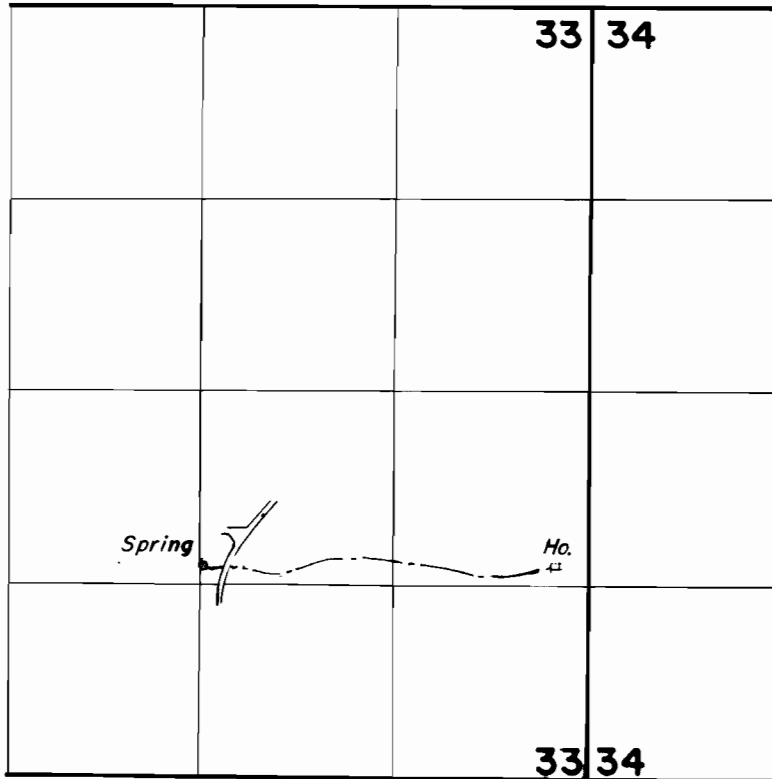

Spring: 120' ± 20' E from SW cor NW $\frac{1}{4}$ SE $\frac{1}{4}$ Sec 33

FINAL PROOF SURVEY UNDER

Application No. 49070 Permit No. 36812.....
IN NAME OF

Ernest C. Catharine, Jr. & William Jarvis.....

Surveyed OCT. 13, 1983, by B. S. JAMES.....