


T. 35 S., R. 5 W., W.M.

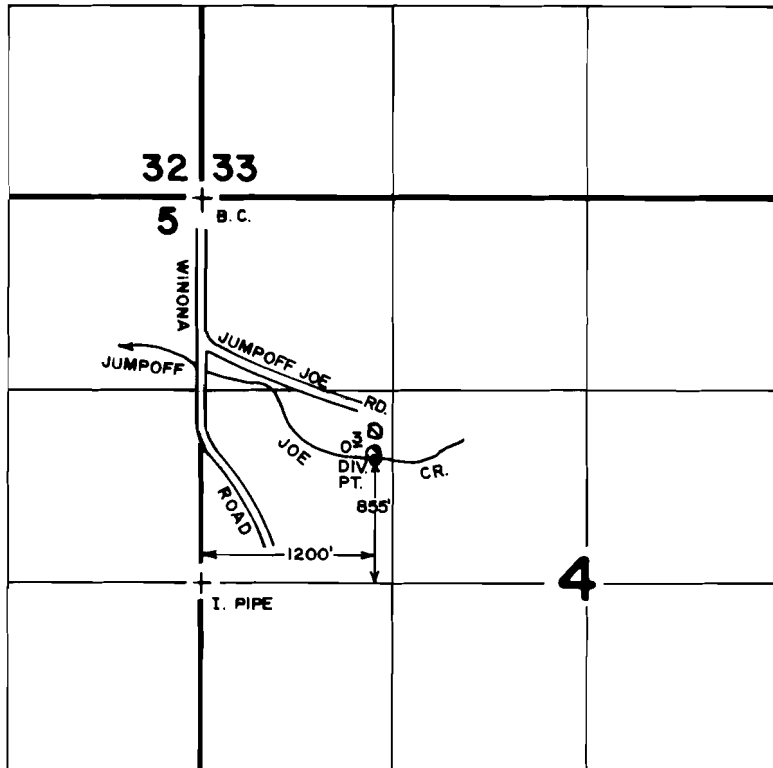

FINAL PROOF SURVEY
UNDER

Application No. 53446 Permit No. 39767

IN NAME OF

WILLARD D. & PHYLLIS A. LYON

Surveyed NOV. 18, 1982, by B. S. JAMES

SCALE: 4" = 1 MILE