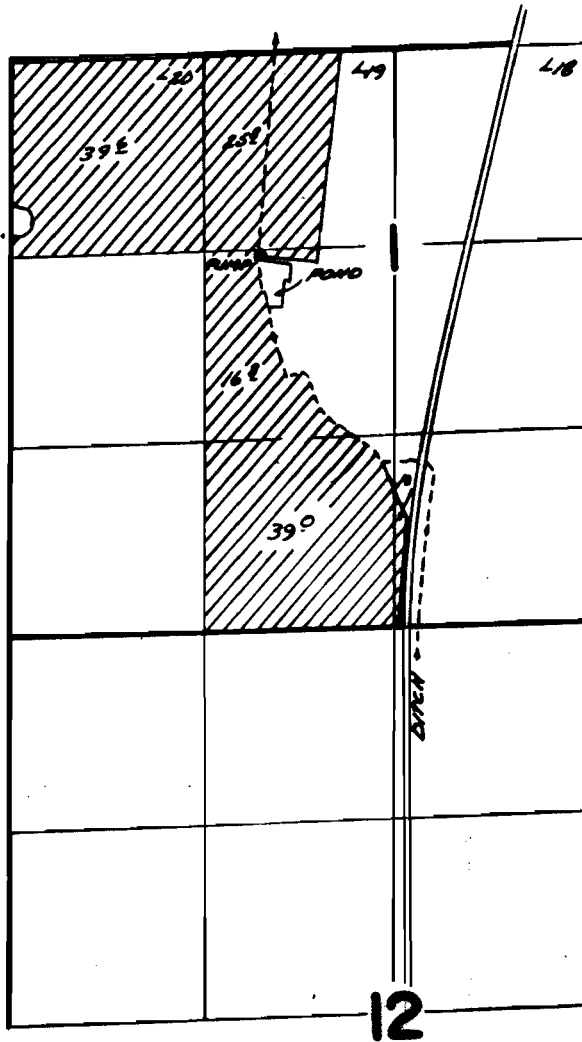
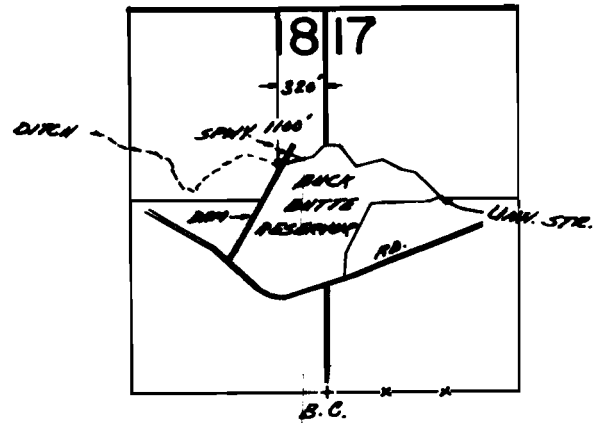


T.40S.R.11E.W.M.



T.40S.R.12E.W.M.



FINAL PROOF SURVEY UNDER

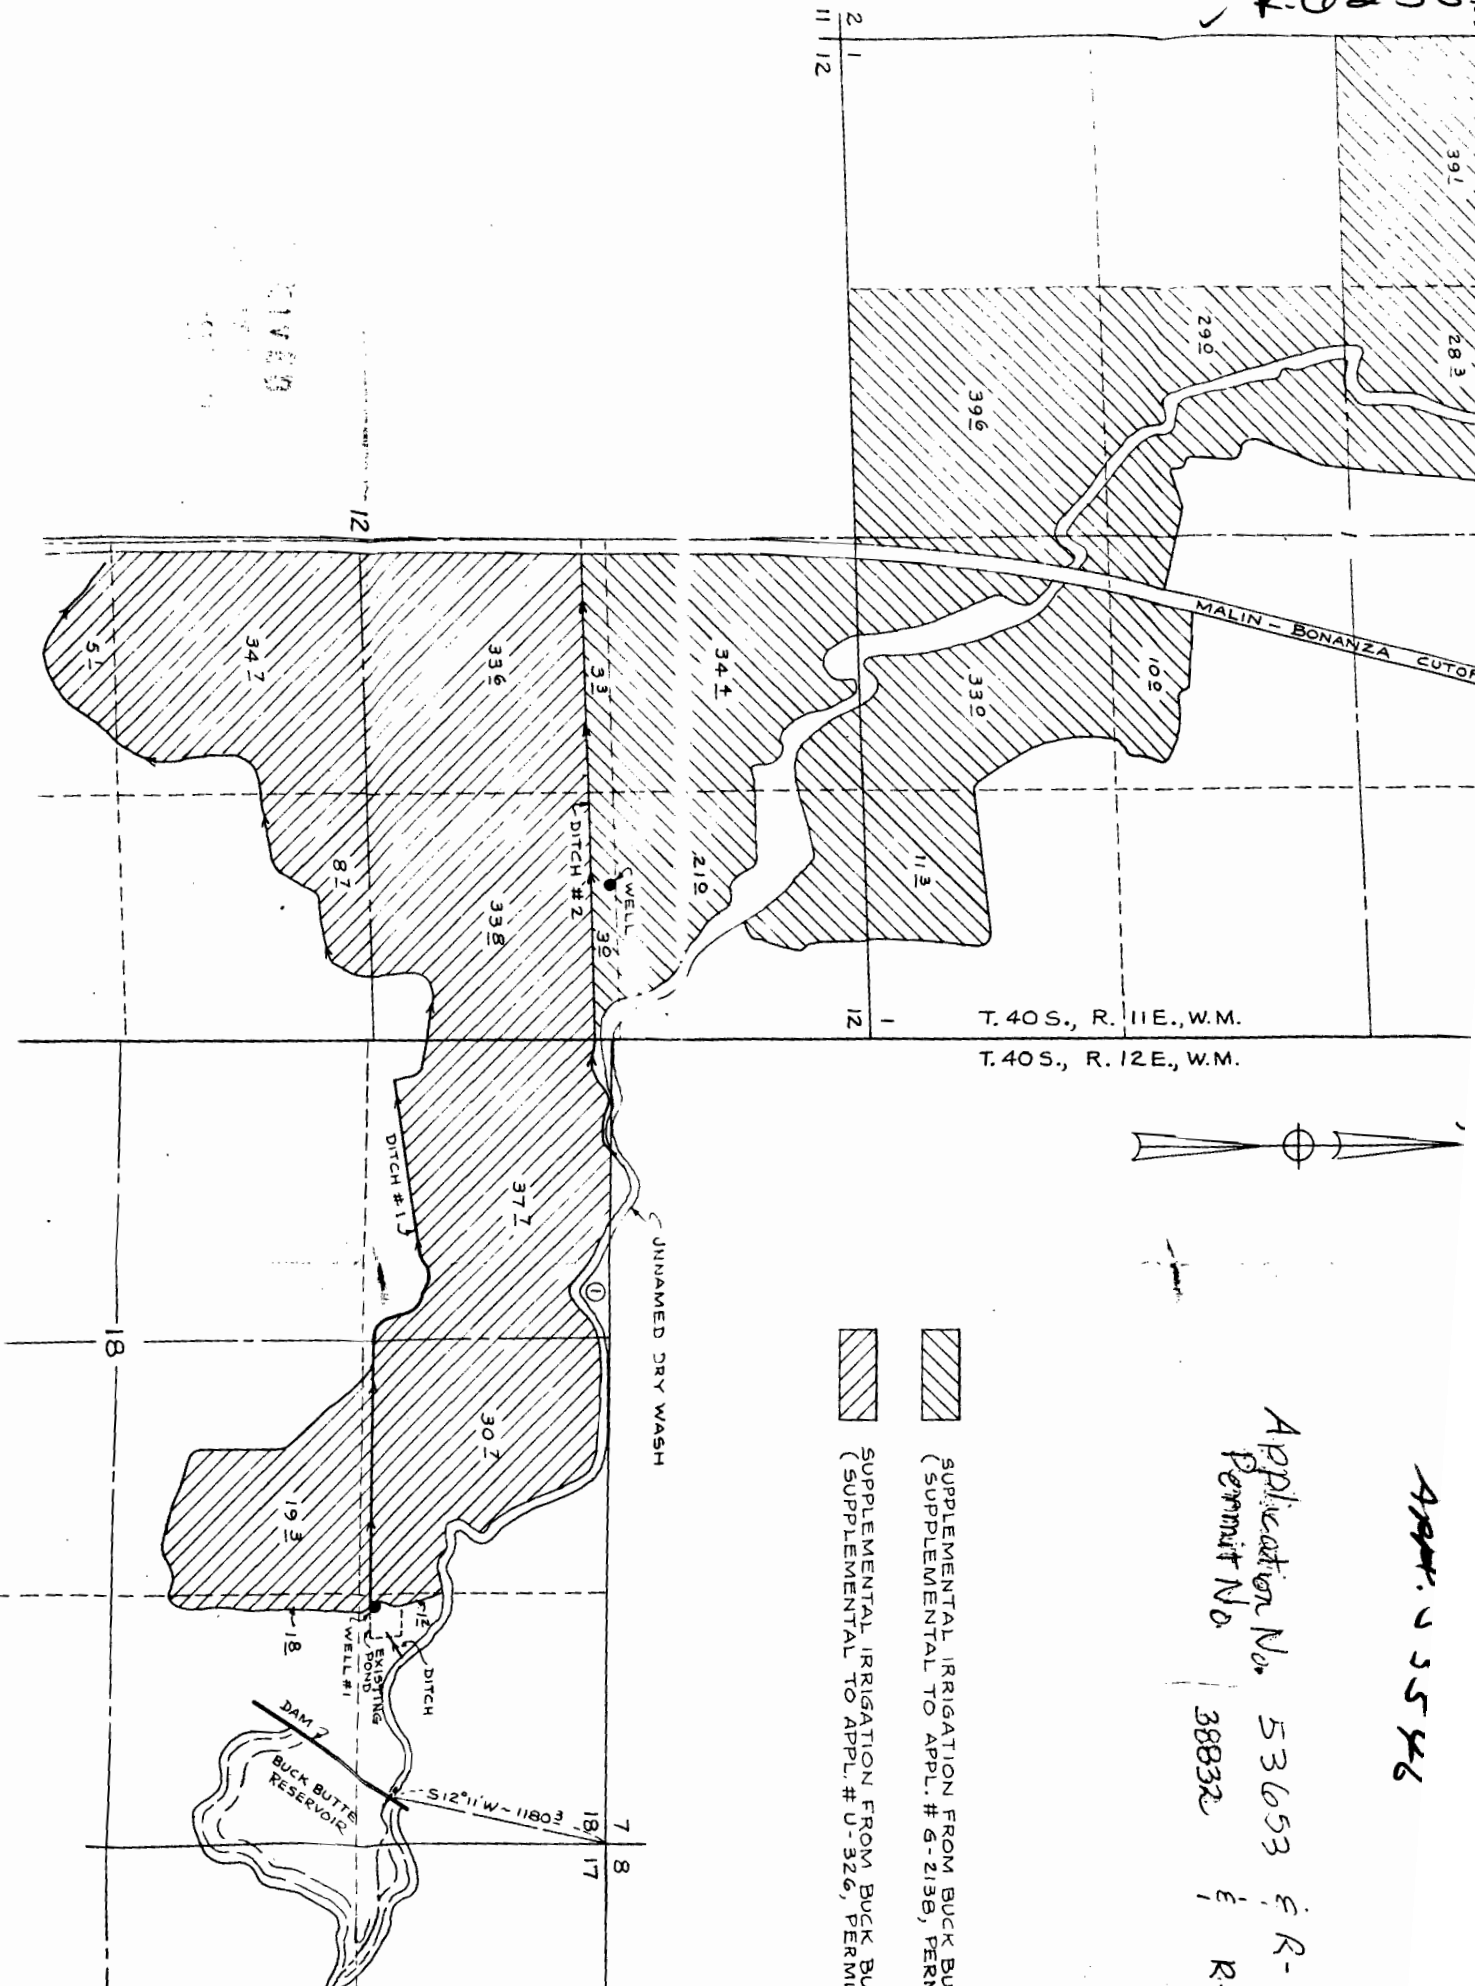
R-53546 R-6238
 Application No. 53653. Permit No. 30832....
 IN NAME OF

.....William J. Rajnus Jr.....



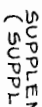
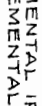
Surveyed Sept. 26, 1972., by C.R. RODRIGUEZ.

R. 6238

East River Main



T. 40S., R. 11E., W.M.
T. 40S., R. 12E., W.M.

-  SUPPLEMENTAL IRRIGATION FROM BUCK BU
-  SUPPLEMENTAL TO APPL. # 6-2130, PERM
-  SUPPLEMENTAL IRRIGATION FROM BUCK BU
-  SUPPLEMENTAL TO APPL. # U-326, PERM

Application No. 53653 § R-
Permit No. 38832 § R

APPL. U 5546