38832

52212

East River Misc.

T.40S.R.11E.W.M.

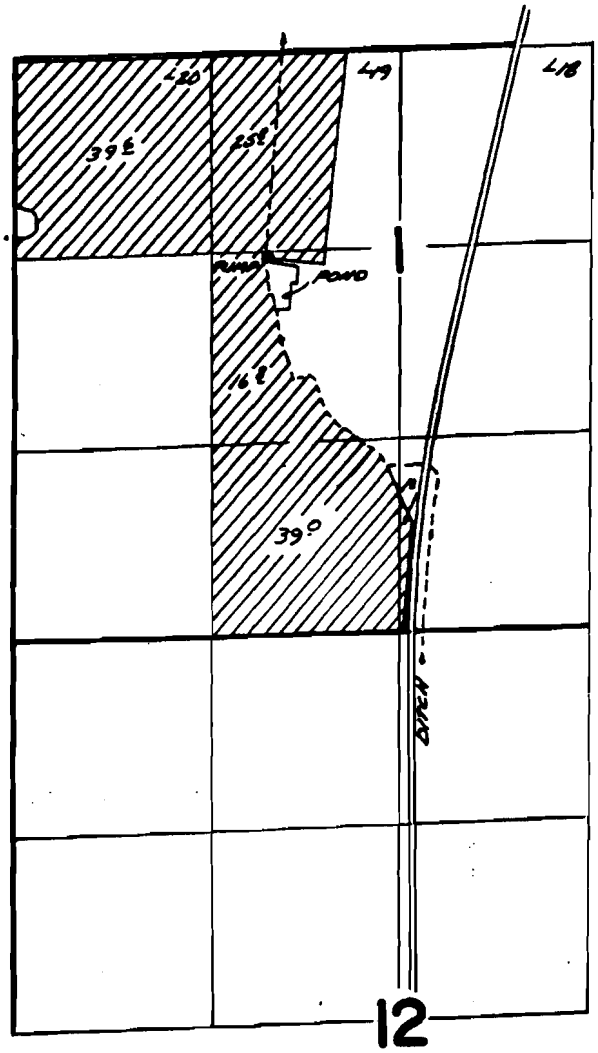

T.40S.R.12E.W.M.

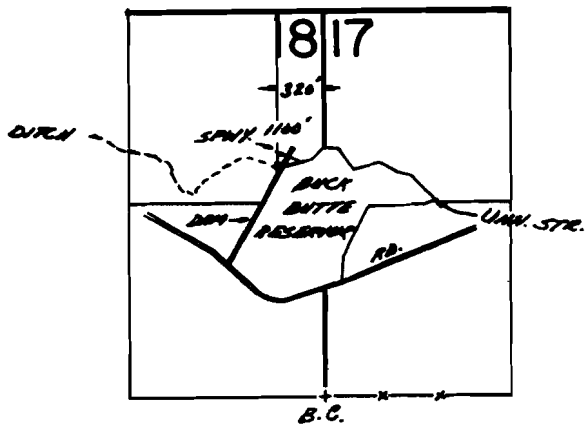

FINAL PROOF SURVEY

UNDER

R-53546 R-6238

Application No. 53653. Permit No. 38832....

IN NAME OF

.....William J. Rajnus Jr.....

Surveyed Sept. 26. 1972., by C.R.RODRIGUEZ.

(CWO-62K-18)
Adj. Pd.-1-6096-B