



T.4N., R.26E., W.M.

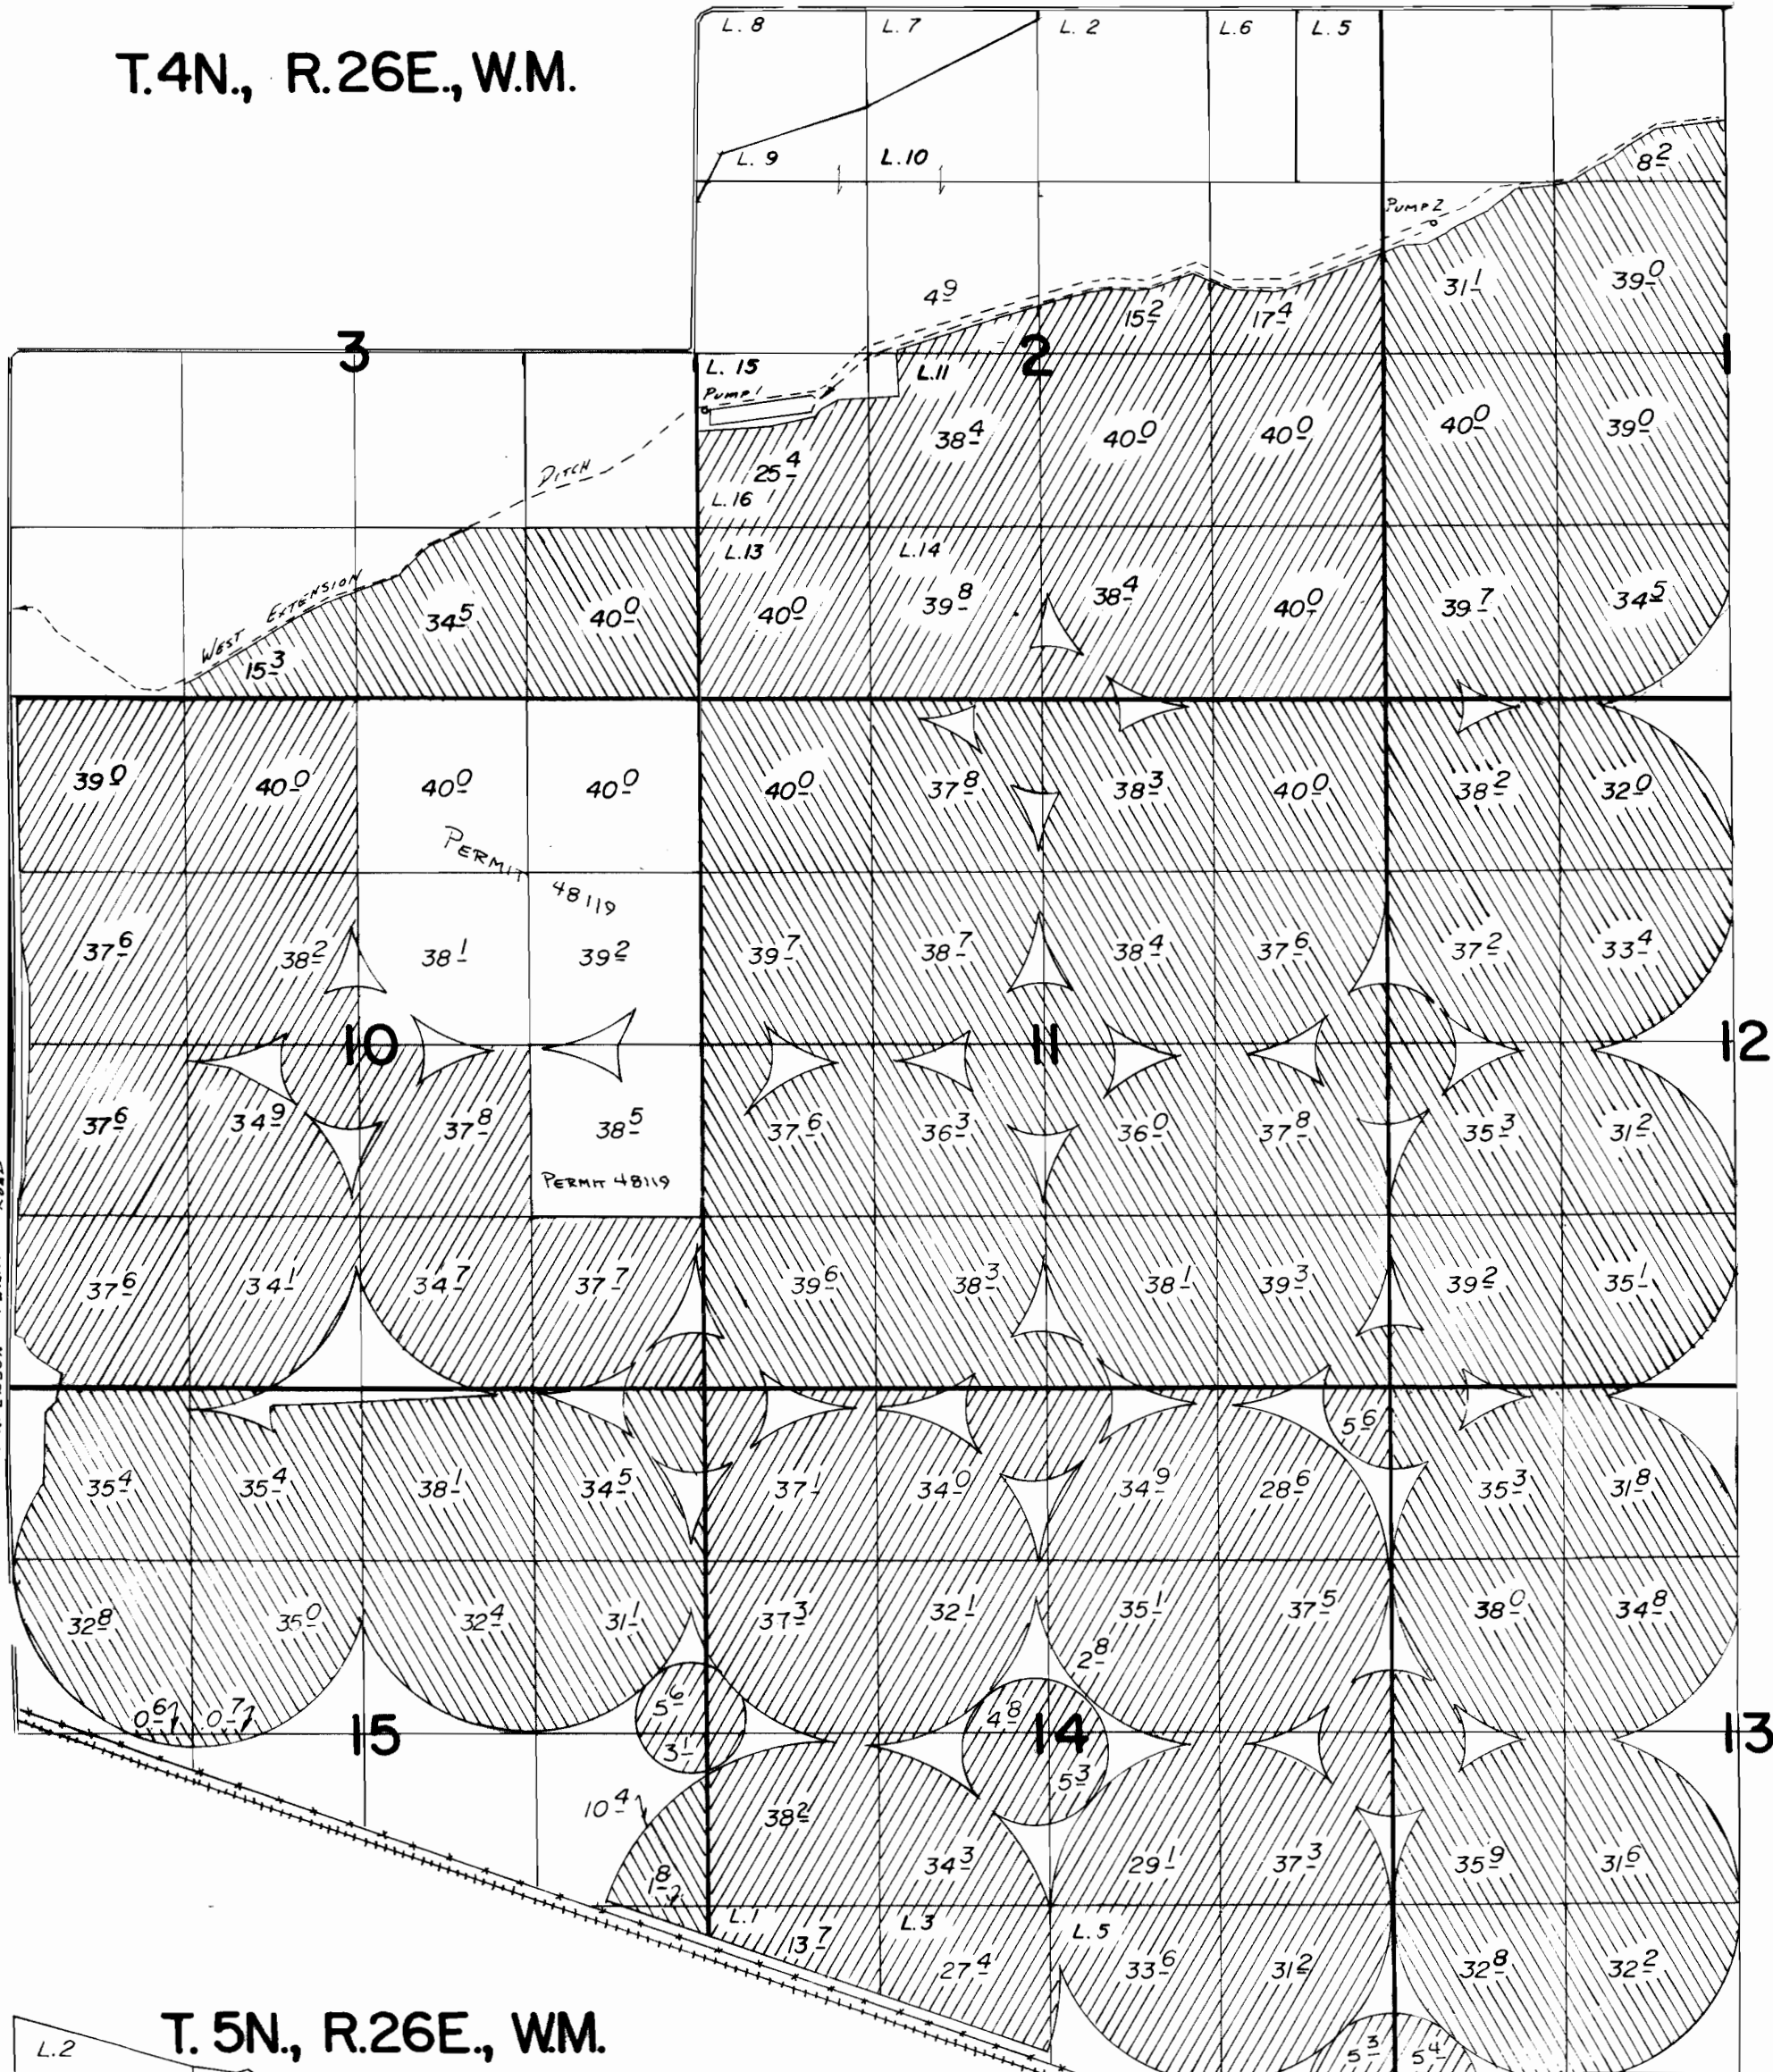

T. 5N., R.26E., W.M.

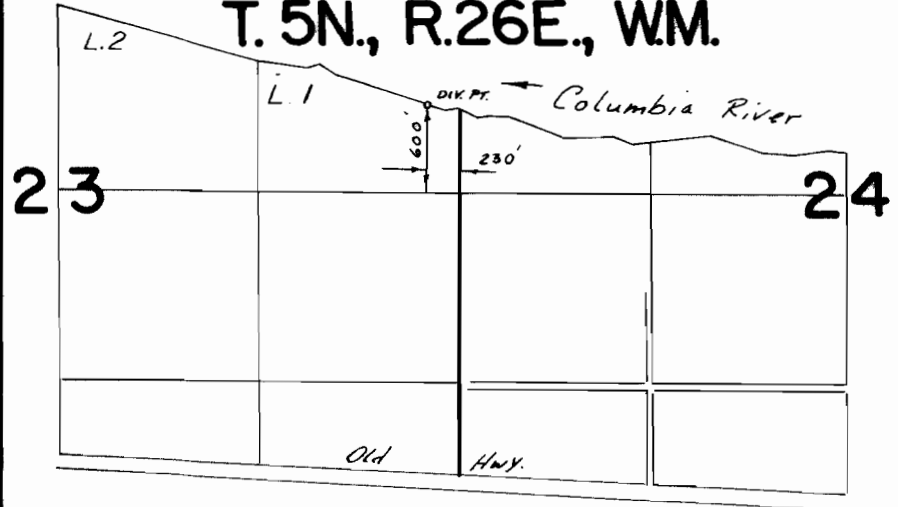

FINAL PROOF SURVEY UNDER

APPL. 43956
58394

PER. 32309
44511



IN NAME OF
WESTERN EMPIRES CORP.

Surveyed 2-24 1981, by V.L. Church
8-31 1983
1-3 1987

SCALE: 1" = 1320'