T 3207

# T. 2S., R. 26E., W.M.

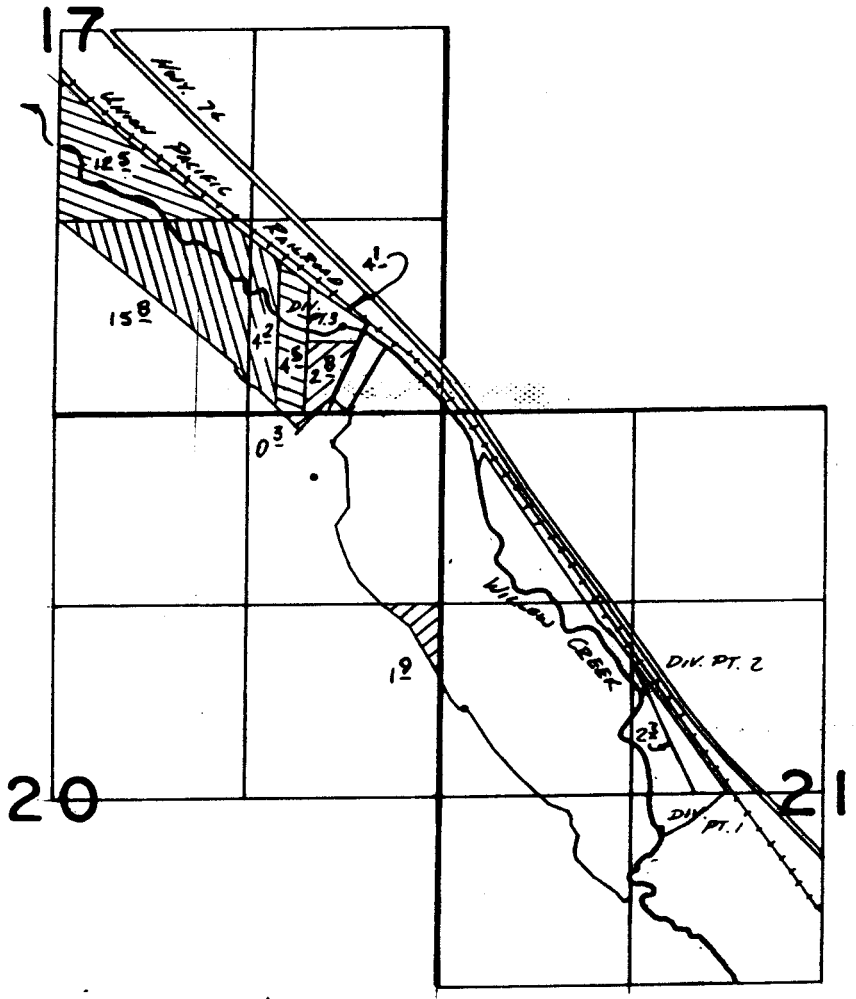


Div. Pt. 1 240'S & 1120'W FROM CENTER SEC. 21
Div. Pt. 2 1950'S & 1490'E. FROM NW COR. SEC. 21
Div. Pt. 3 600'N. & 680'W. FROM SE COR. SEC. 17

**FINAL PROOF SURVEY**
**UNDER**

**TRANSFER 3207**

1891
1884
1889

[redacted]

**IN NAME OF**

**MRS. ANNA GRAHAM**

Surveyed Oct. 11 1982, by V.L. Church

U.29

1094