


- 15841

T.2N.R.12E.W.M.

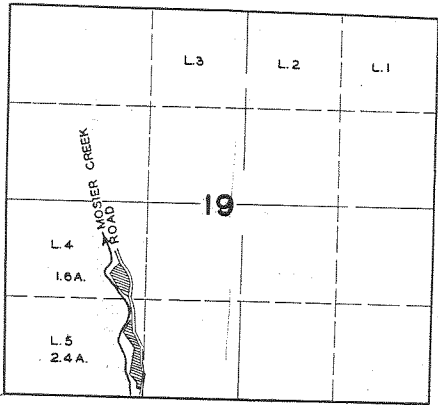

FINAL PROOF SURVEY
 UNDER

Application No. 20307. Permit No. 15841.
 IN NAME OF

CHARLES E. & MINNIE H. REESE

Surveyed JULY 14 1950., by H.L. COFFMAN.