


T 11 9 T L 20

# T.3S.R.12E.W.M.

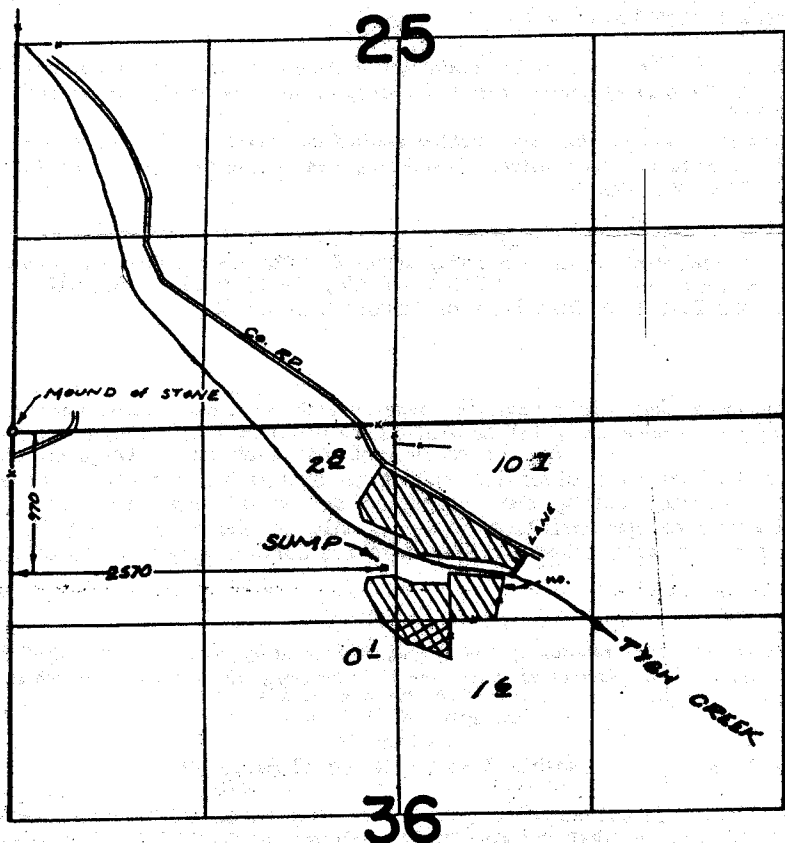

 PRIMARY
  SUPPLEMENTAL

## FINAL PROOF SURVEY UNDER

Application No. G-1487 Permit No. G-4230

IN NAME OF

**RALPH DELCO**

Surveyed Nov 2, 1971, by R. MUCKEN.