


T.1N.,R.4W.,W.M.

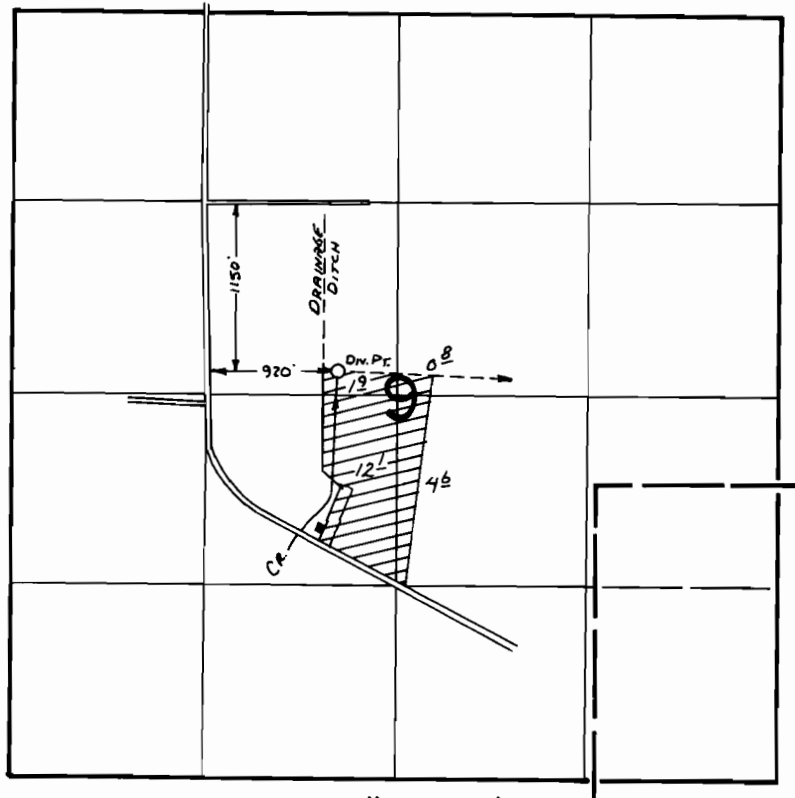

SCALE: 1" = 1320'

FINAL PROOF SURVEY UNDER


Application No. 24237... Permit No. 19209.....
IN NAME OF

.....**HOWARD M. ROBERTSON**.....

Surveyed July...11... 1952., by H.L. COFFMAN....

Superceded
3/8/84

T.1N.R.4W.W.M.

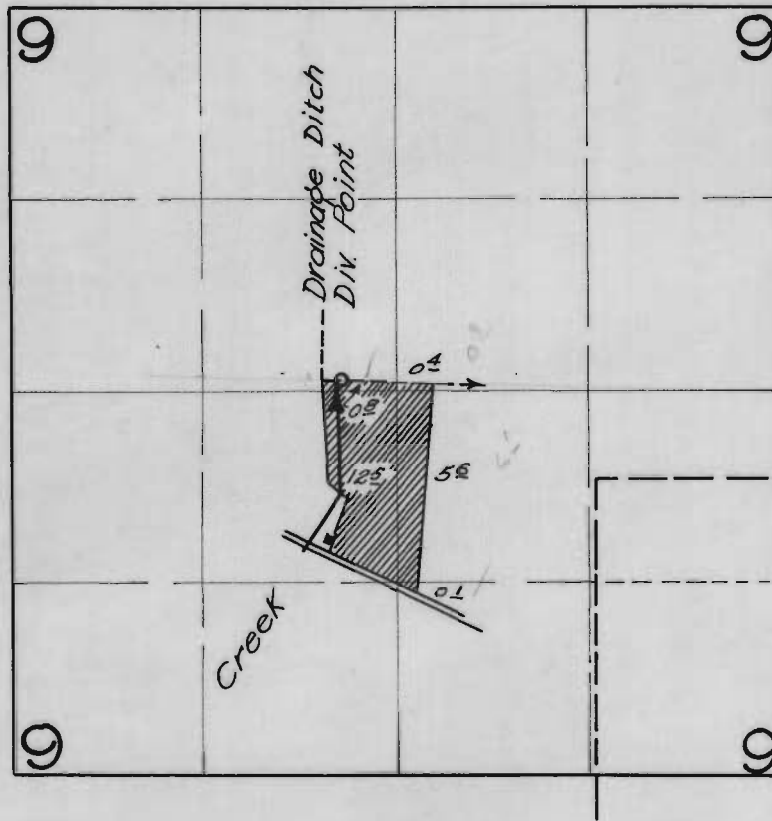

FINAL PROOF SURVEY
UNDER

Application No. 24237 Permit No. 19209
IN NAME OF

HOWARD M. ROBERTSON

Surveyed 7 / 11 19 52, by H. L. COFFMAN