


T.11 & 12S. R.19 & 20E. W.M.

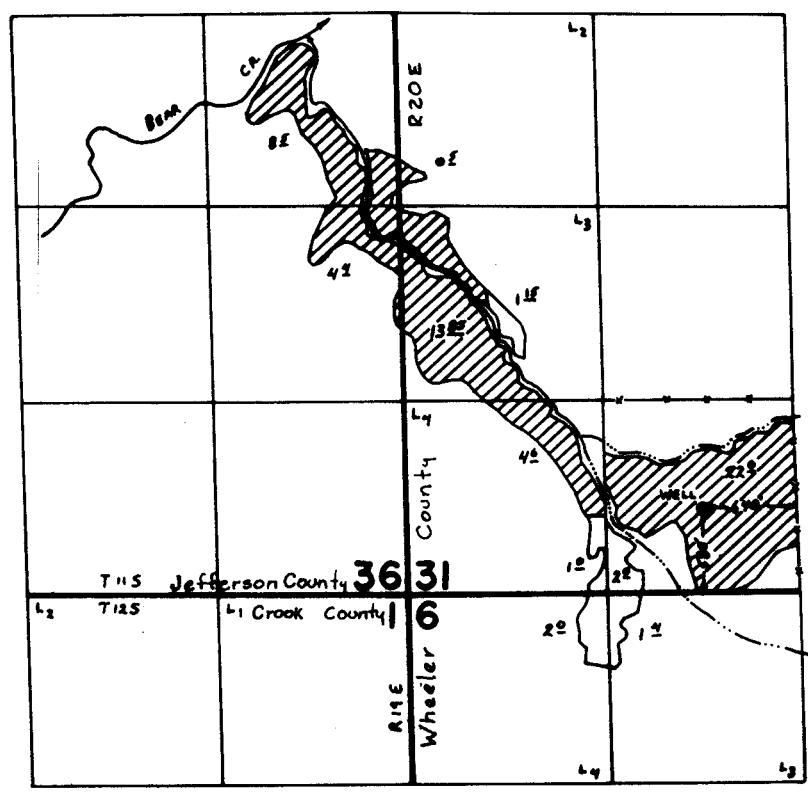

**FINAL PROOF SURVEY**  
UNDER

Application No. ~~G-8799~~ Permit No. G-8228.....  
IN NAME OF

**BEAR CREEK LAND & CATTLE CO.**

Surveyed July...26.. 19.79, by C.L.HUGHES.....