


T. 8 S. R. 1 W. W. M.

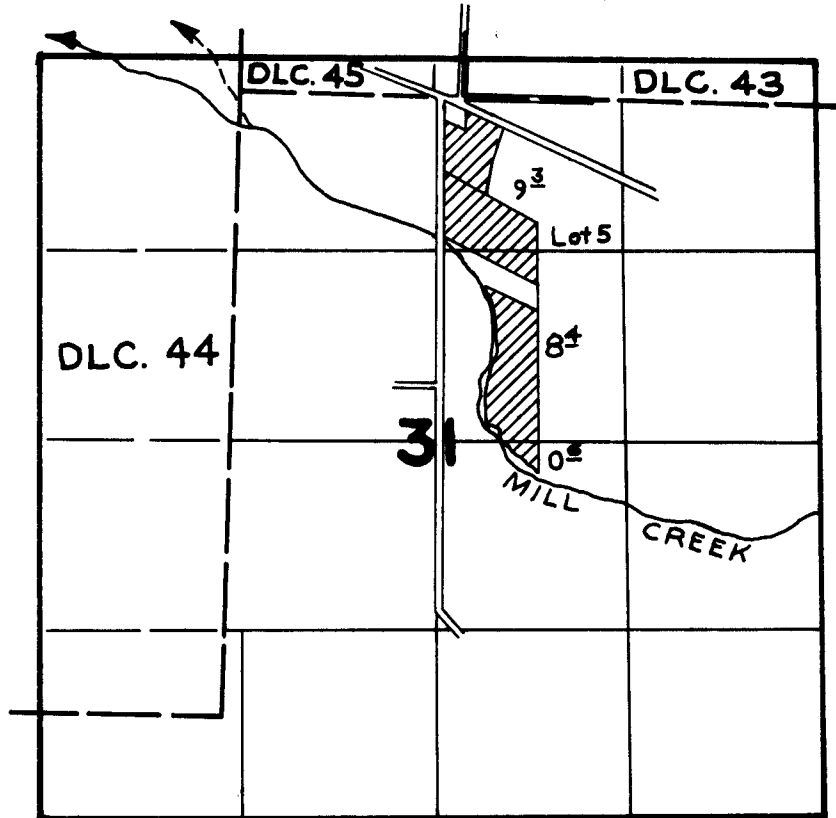

FINAL PROOF SURVEY

UNDER

Application No. E-81 Permit No. E-82

IN NAME OF

CHAS. D. & BETTY BURNS

Surveyed JUL 12, 19 78, by L. NUNN