


T.8S. R.2W. W.M.

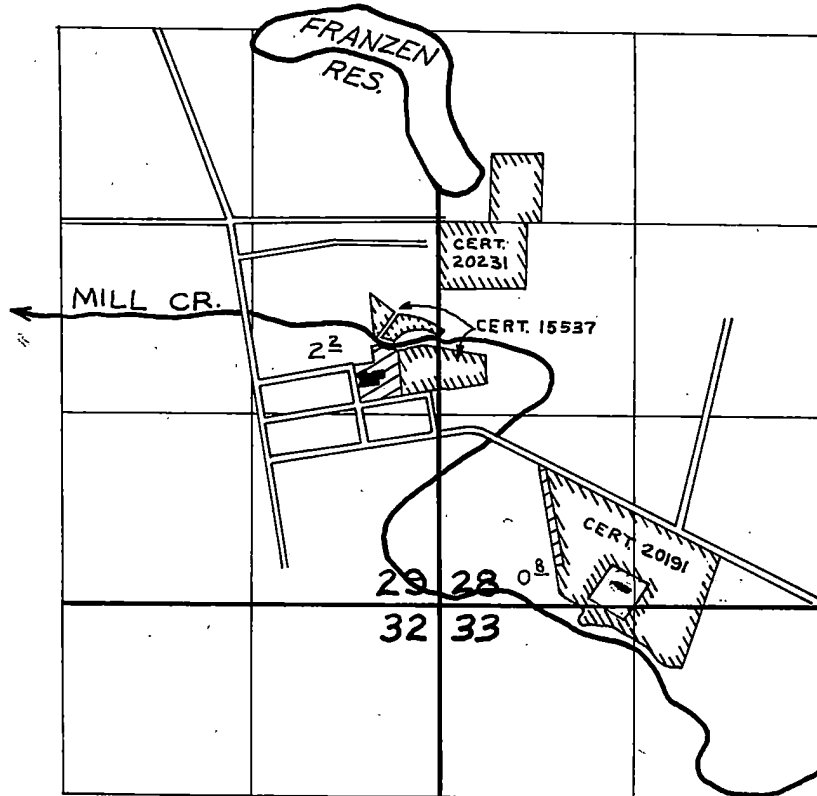

FINAL PROOF SURVEY

UNDER

Application No. E-81 Permit No. E-82

IN NAME OF

TURNER MEMORIAL HOME

Surveyed JUL 9, 1979, by C. HUGHES