


RECEIVED

JUL 1984
WATER RESOURCES DEPT

T. 7S., R. 48E., W.M.

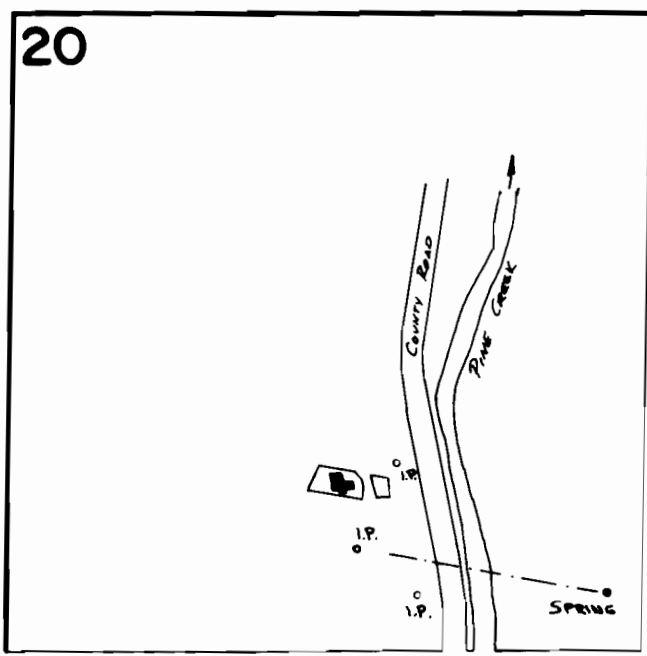

SPRING Loc: 1200'S. & 1240' E. FROM NW. COR. SEC. 20



FINAL PROOF SURVEY
UNDER

SCALE 1" = 400'

Application No. **60506** Permit No. **45300**...
IN NAME OF

.....**JOSE VALCARCEL**.....

Surveyed *May 23* 1984, by *V. L. Church*.....