


TIIS. R6W. WM.

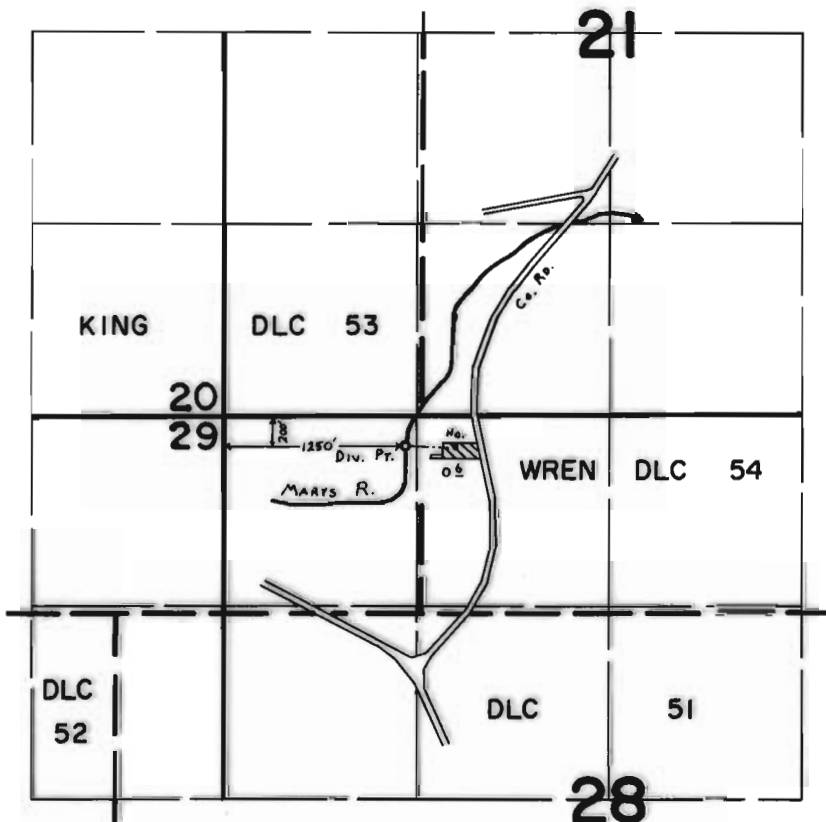

FINAL PROOF SURVEY UNDER

Application No. 49801 Permit No. 37465
IN NAME OF

LEE & CLARA SIMPSON

Surveyed May 4 1979 by C. L. HUGHES