


# T12S. R6W. WM.

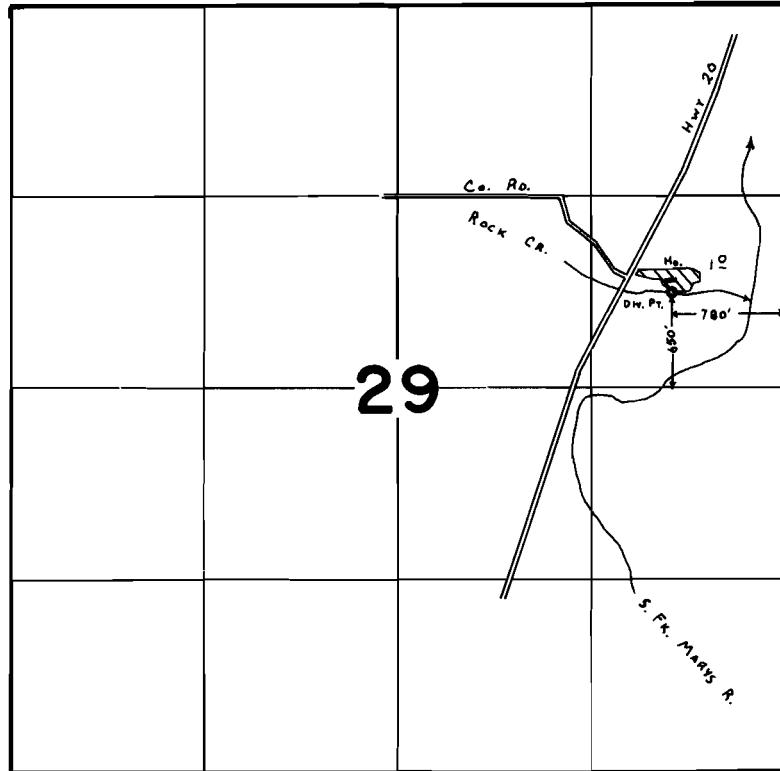

## FINAL PROOF SURVEY UNDER

Application No. ..50615.. Permit No. ..38249.....  
IN NAME OF

.....**DENNIS R. NUSBAUM**.....

Surveyed ..May...4... 19.79., by ..C. L. HUGHES.....