


# T12S. R5W. WM.

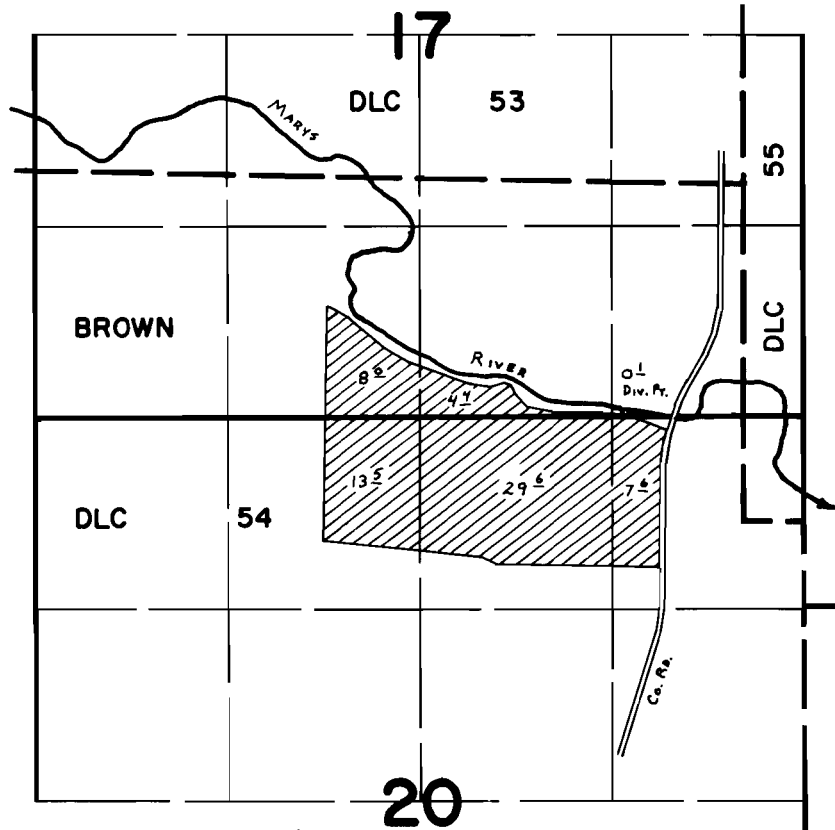

Div. Pt. Loc: 30' N. & 1220' W. fr. S.E. Cor. Sec. 17.

## FINAL PROOF SURVEY UNDER

Application No. 52157 Permit No. 39279  
IN NAME OF

CROCKER FARMS

Surveyed Sept. 5, 1979, by C. L. HUGHES