


T.12S. R.5W. W.M.

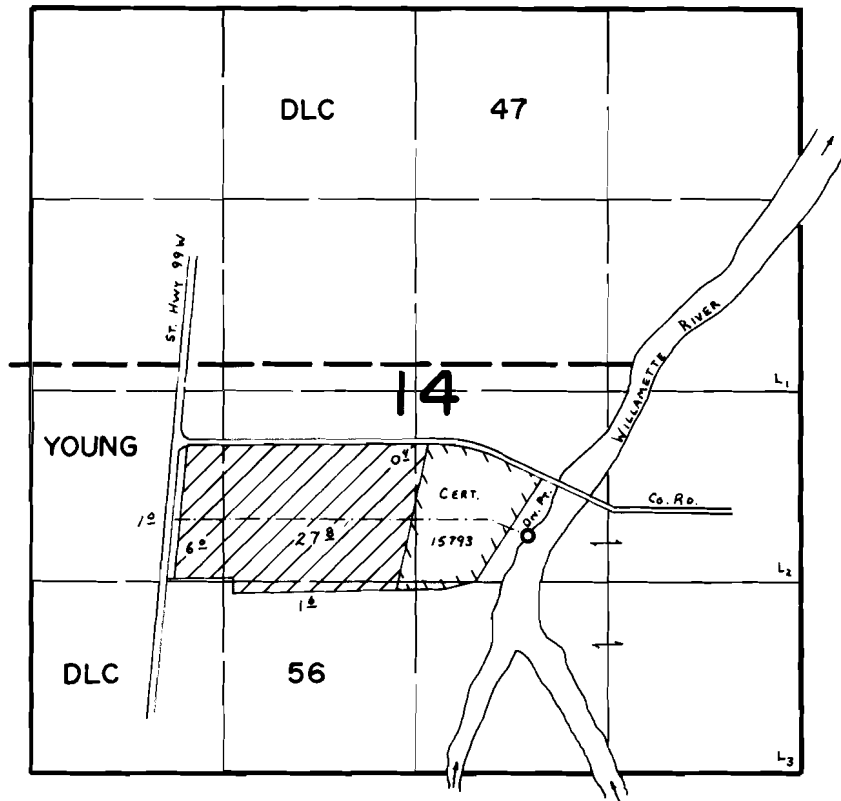

Div. Pt. Loc: 1630' N. & 1860' W. fr. S.E. Cor. Sec. 14.

FINAL PROOF SURVEY
UNDER

Application No. 54428.. Permit No. 40815.....
IN NAME OF

.....IVAN CHORAK.....

Surveyed May 27, 1980, by C.L. Hughes.....

Harvey Young DLC 56