


T13S. R5W. WM.

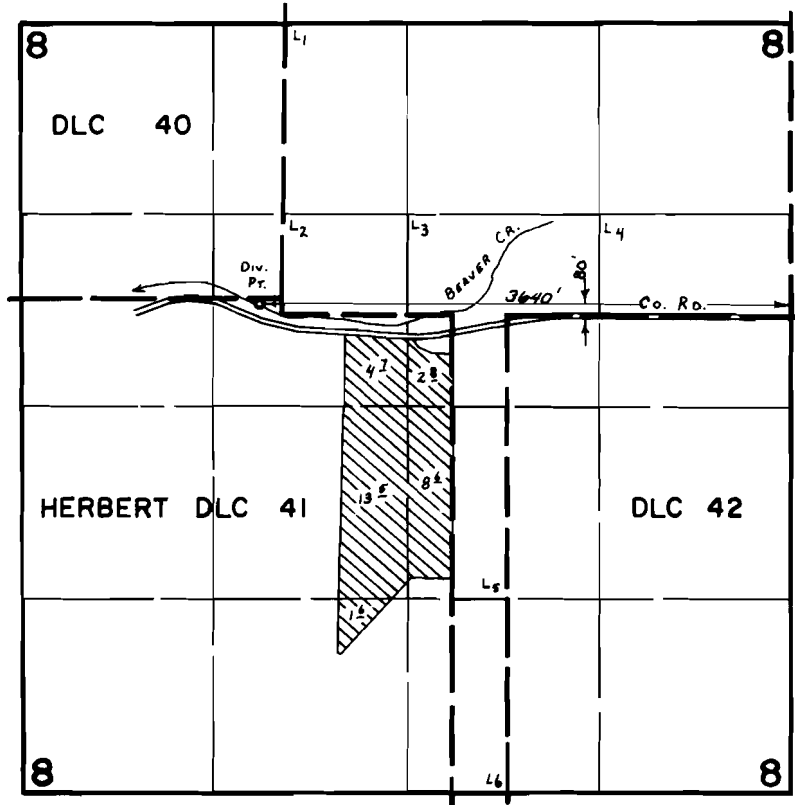

FINAL PROOF SURVEY UNDER

Application No. 55768 Permit No. 41760.....
IN NAME OF

J. R. RICE

Surveyed Aug. 17, 1979, by C. L. HUGHES