T12S. R4 & 5W. WM.

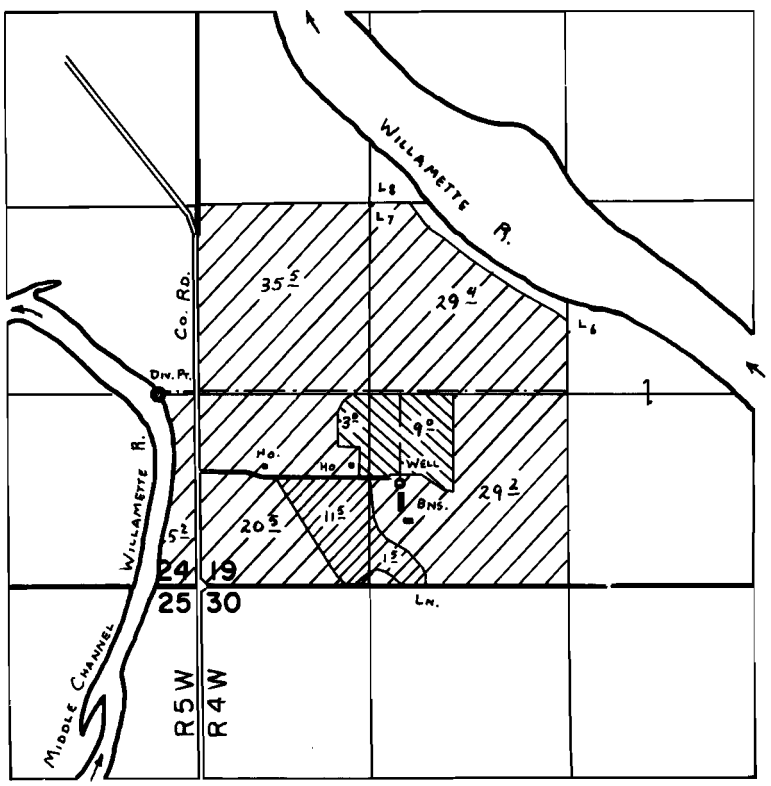

DIV. PT. LOC: 1320' N. & 280' W. fr. S.E. COR. SEC. 24.

- PRIMARY G.R. CERT. 3193 } SUPPLEMENTAL - APP. # 55258
- PRIMARY G.R. CERT. 3192 }
- PRIMARY APP. #55258.

FINAL PROOF SURVEY
UNDER

Application No. 55258 Permit No. 43296
IN NAME OF

JAMES C. HATHAWAY

Surveyed Oct. 4 1979, by C. L. HUGHES

DFJ-2LL-74