

RECEIVED


DEC 4 1978

WATER RESOURCES DEPT.
SALEM, OREGON

T. 14 S. R. 8 W. W. M.

Shook

THIS DOCUMENT IS TO BE FILED BY THE APPLICANT

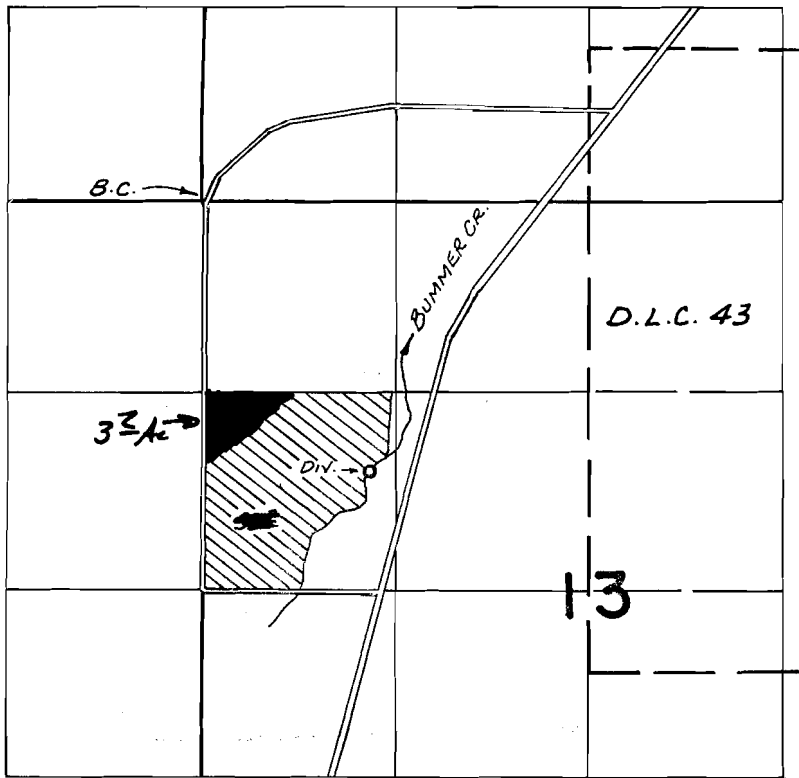

DIV. PT. LOC: 1860'S & 1130'E. FROM N.W. COR. SEC. 13

Application No. 55137

Permit No. 43807

FINAL PROOF SURVEY
UNDER

Application No. 50183... Permit No. 36793...
IN NAME OF

FRED H. & ESTHER CALLAHAN

Surveyed SEPT. 20 1977, by B.O.B. BARWIN