


# T12S. R6W. WM.

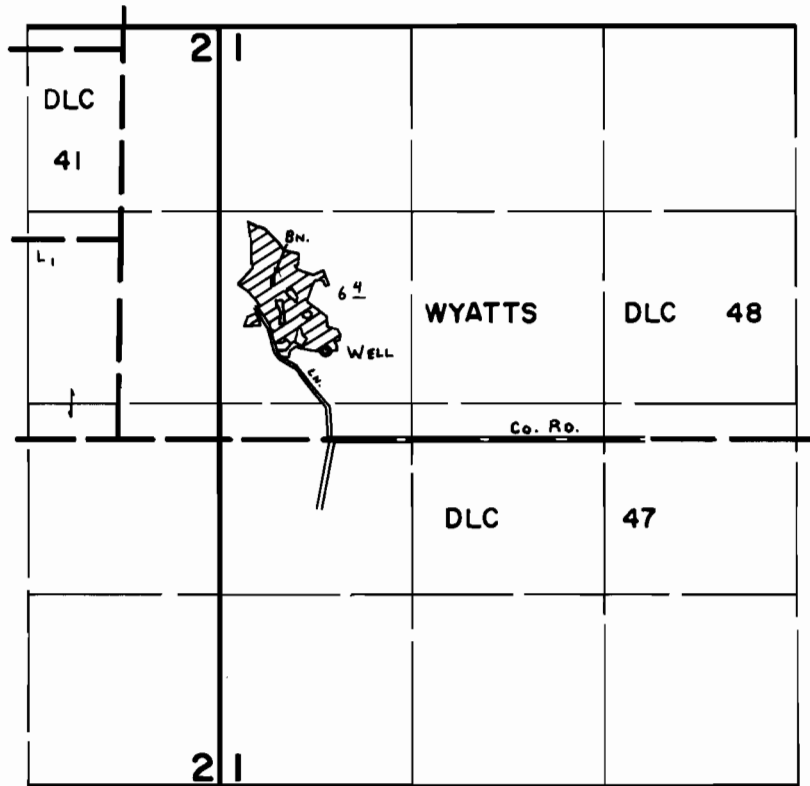

WELL LOC: 610' N. & 1420' E. fr. S.W. COR. WYATTS DLC 48.

## FINAL PROOF SURVEY UNDER

Application No. G-6360 Permit No. G-5958  
IN NAME OF

**JAMES S. MCBEE**

Surveyed May 2, 1979, by C. L. HUGHES.