


T12S. R5W. WM.

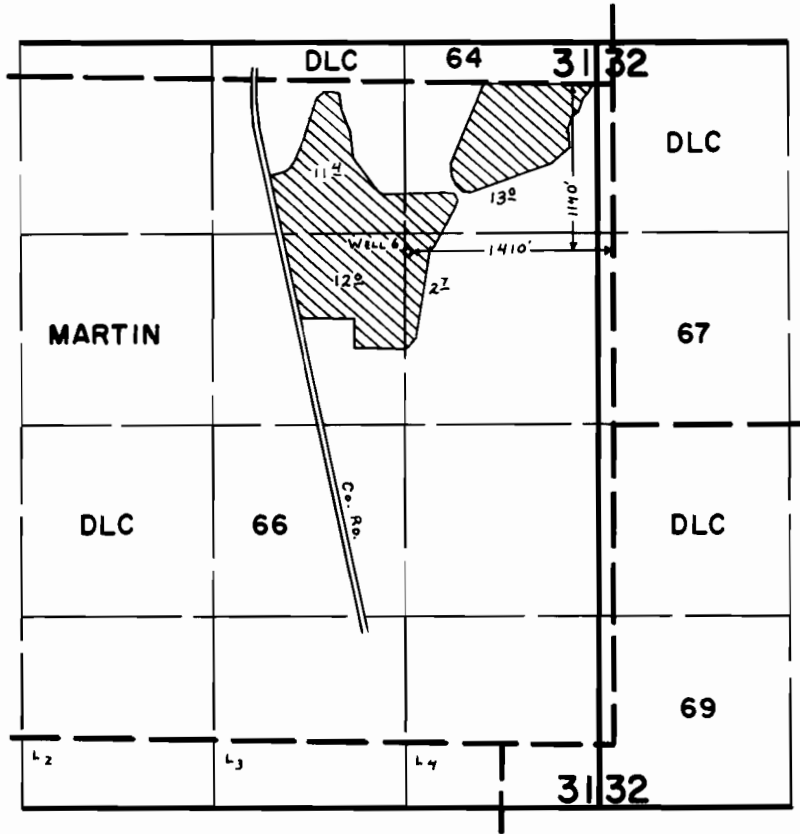

FINAL PROOF SURVEY UNDER

Application No. G-7896 Permit No. G-7303
IN NAME OF

LEIGHTON DAVIS

Surveyed May 4, 1979, by C. L. HUGHES