


T12S. R4 & 5W. WM.

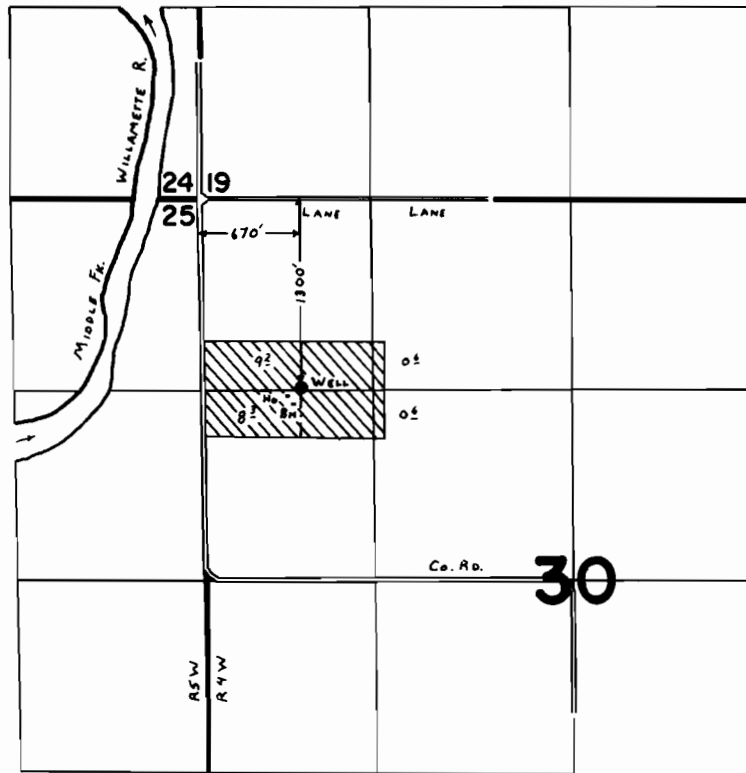

FINAL PROOF SURVEY UNDER

Application No. G-8284 Permit No. G-7802
IN NAME OF

PETER R. CHEEKE

Surveyed Oct. 4 1979, by C. L. HUGHES