


T.4S. R.3 & 4E. W.M.

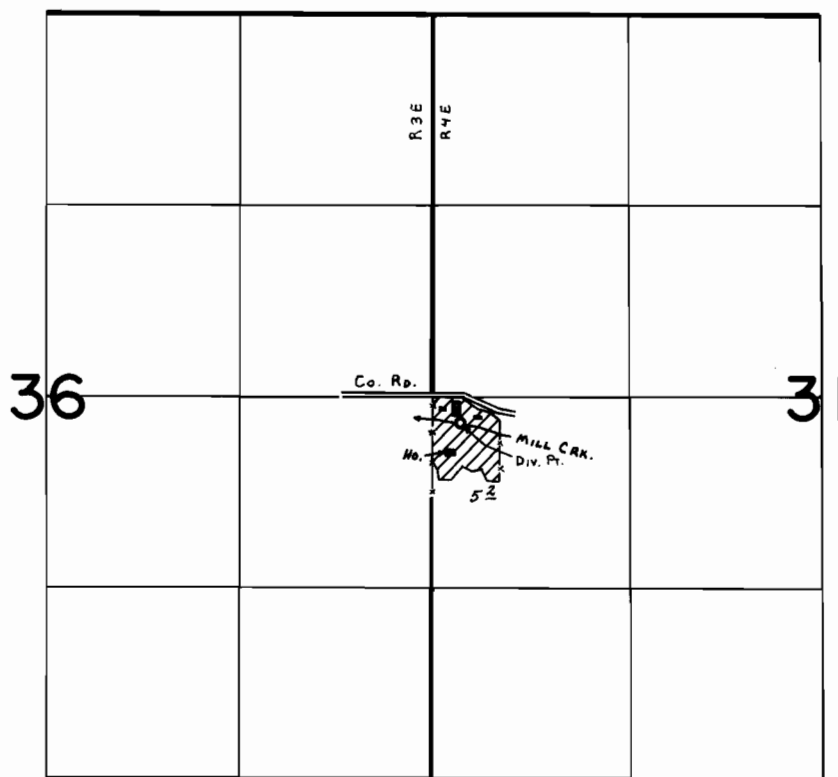

Div. Pt. Loc: 180'S. & 190'E. fr. W. 1/4 COR. SEC. 31.

FINAL PROOF SURVEY
UNDER

Application No. 52455 Permit No. 39447...
IN NAME OF

OSCAR N. PETERSON

Surveyed Oct. 17 1979, by C. L. HUGHES...