


T.4S. R.2E. W.M.

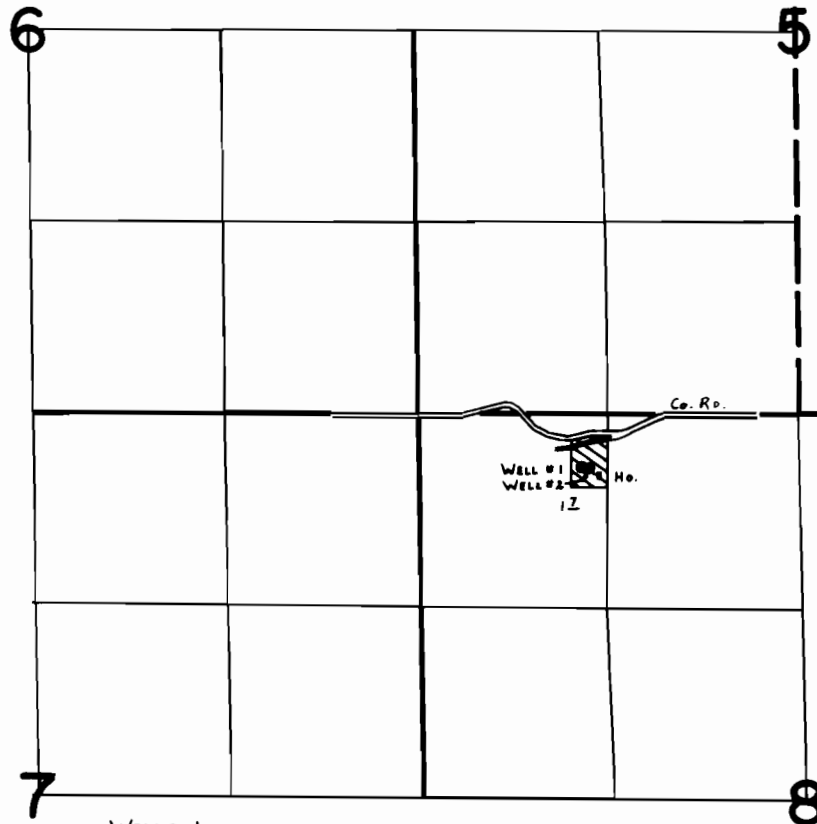

WELLS LOC:
#1- 370'S. & 1110'E. } BOTH FROM N.W. COR. SEC. 8.
#2- 380'S. & 1160'E. }

FINAL PROOF SURVEY
UNDER

Application No. ~~G-6136~~ Permit No. ~~G-5830~~....
IN NAME OF

GEORGE E. & SHIRLEY M. LYONS

Surveyed Oct. 16, 1979, by C. L. HUGHES