


T.5S. R1E. W.M.

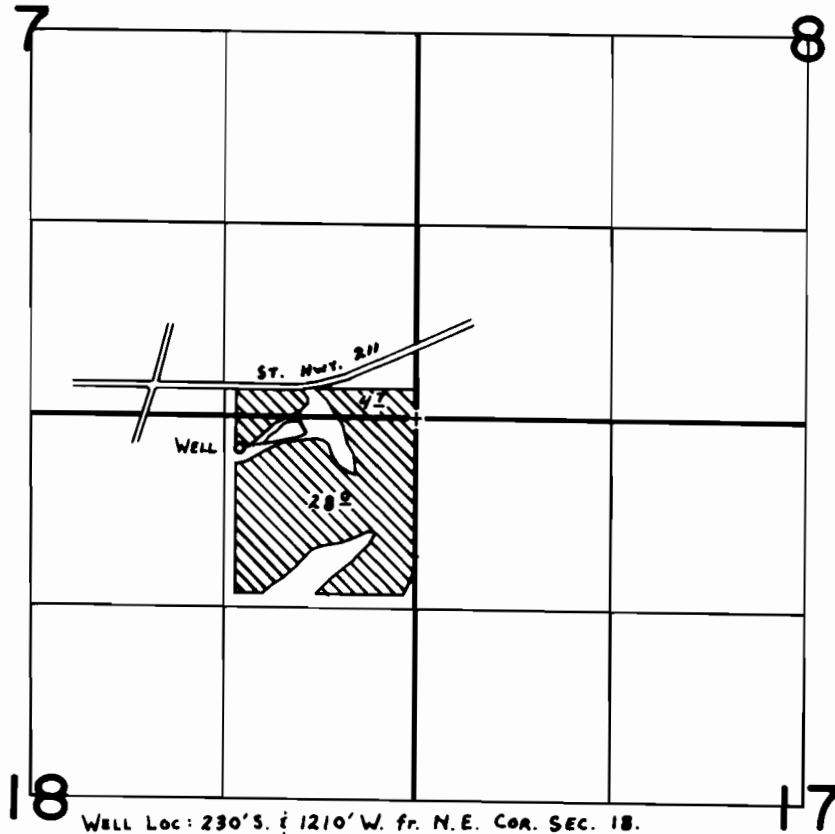

FINAL PROOF SURVEY UNDER

Application No. G-6145 Permit No. G-5835.....
IN NAME OF

WARREN BREMER.....

Surveyed Oct. 11 1979, by C.L. HUGHES.....