


T.5S. R.1E. W.M.

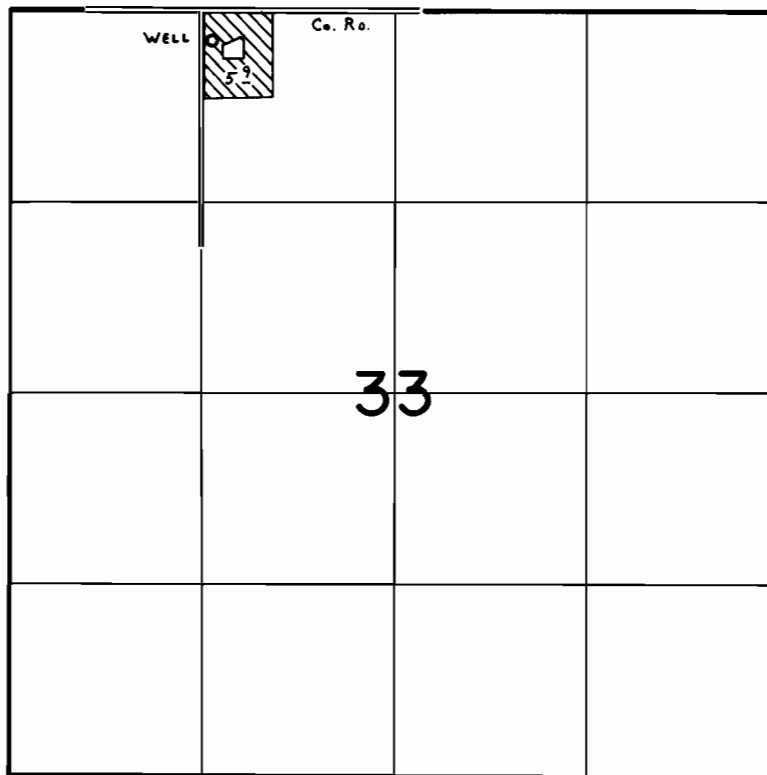

WELL Loc: 210'S. & 1380'E. fr. N.W. Cor. Sec. 33.

FINAL PROOF SURVEY
UNDER

Application No. G-6416 Permit No. G-5995
IN NAME OF

EUGENE R. SCHMITZ

Surveyed Oct. 12 1979, by C. L. HUGHES