


T.5S. R.1E. W.M.

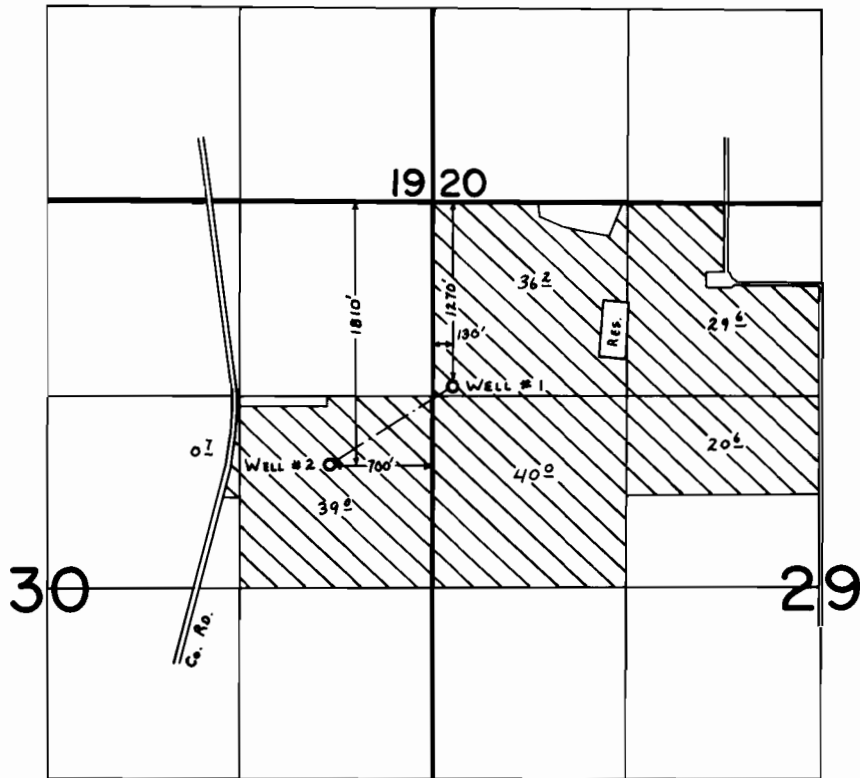

FINAL PROOF SURVEY
UNDER

Application No. ~~G-7823~~ Permit No. ~~G-7223~~....
IN NAME OF

C. J. VANDECOEVERING

Surveyed Oct. 12, 1979, by C. L. HUGHES