


T.29S. R.IIW. W.M.

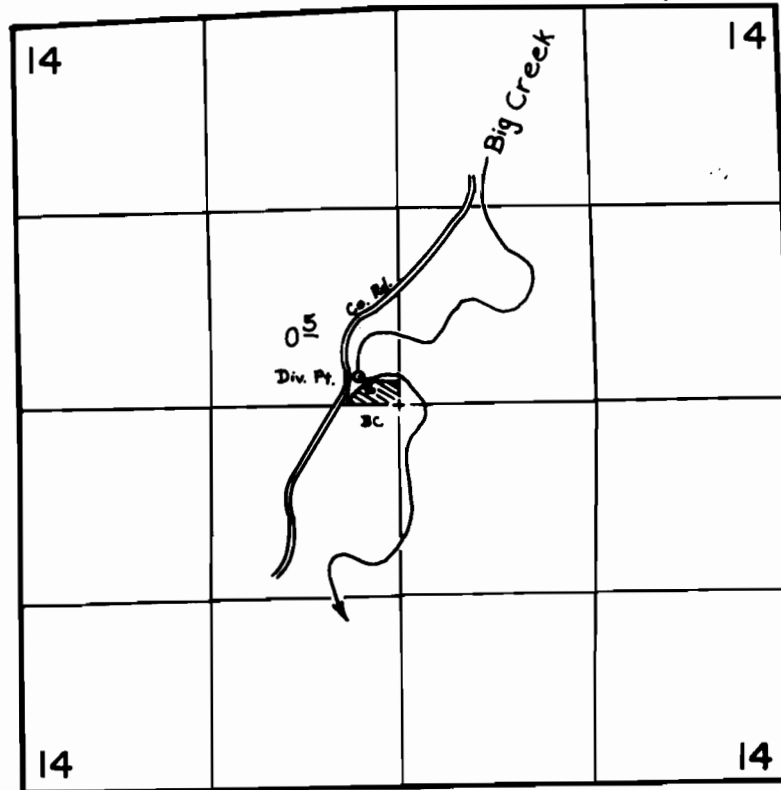

Div. Pt. Located: 180' N & 270' W from C/4 cor. Sec. 14

SCALE: 4" = 1 mile

FINAL PROOF SURVEY
UNDER

Application No. 55190 Permit No. 41404
IN NAME OF

RICHARD W. WELLS

Surveyed Sept. 25, 1979, by S. Donaldson...