


T.17S. R.21E., W.M.

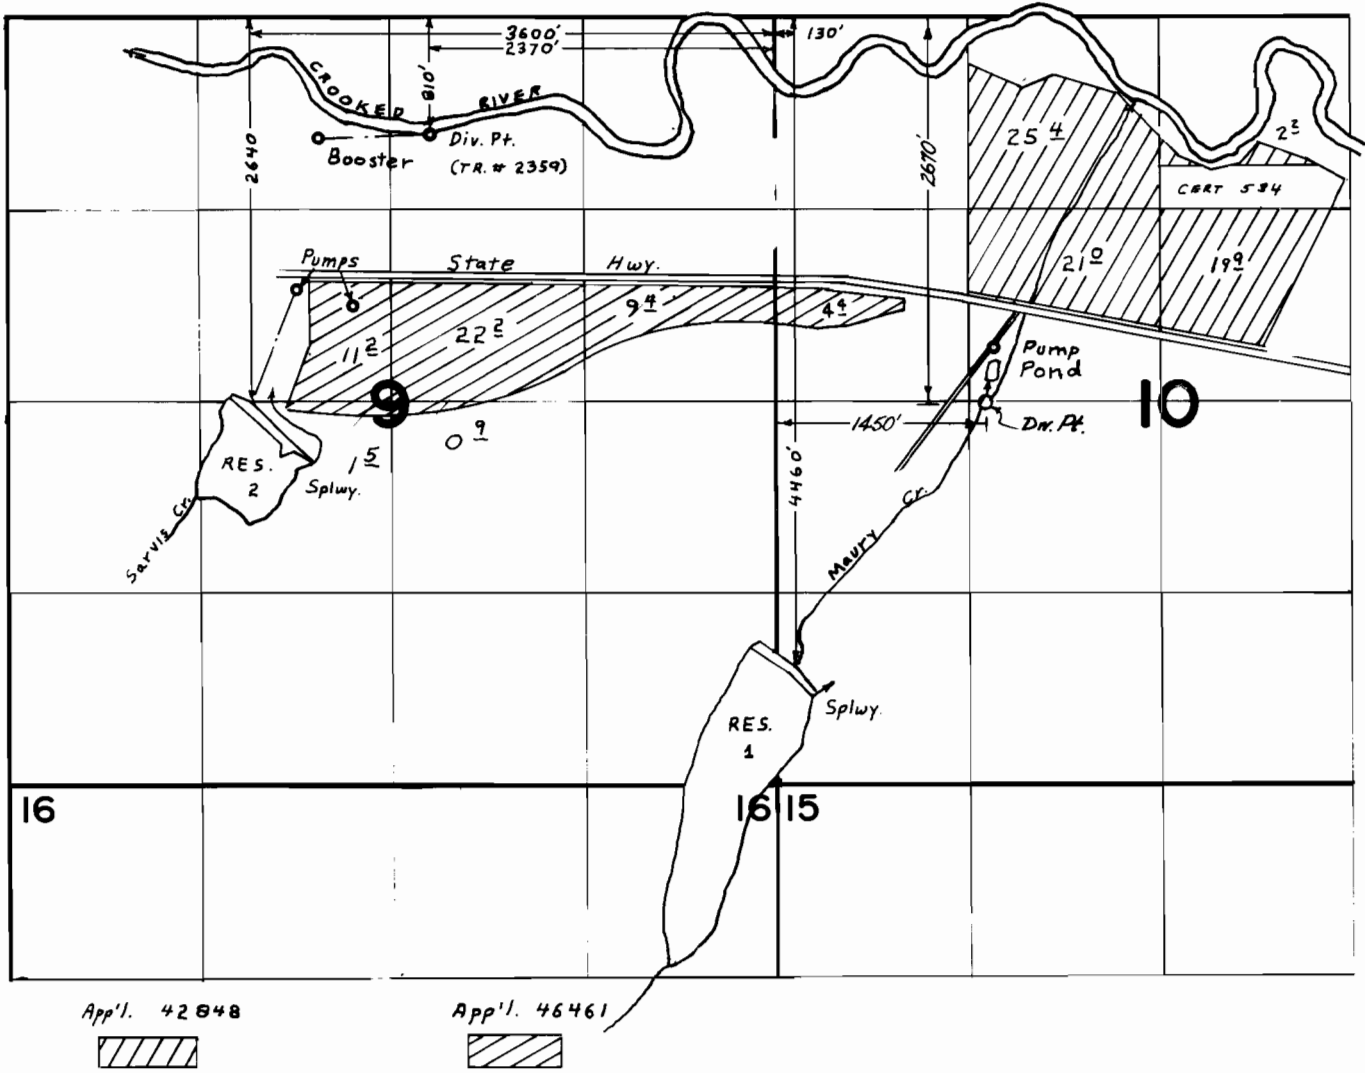

Transfer No. 2359

FINAL PROOF SURVEY

UNDER

R-42847

R-4871

42848

32025

46461

34710

Application No. R-46462 Permit No. R-5534

IN NAME OF

LES SCHWAB TIRE CENTERS, INC.

Surveyed JUL 11/12 1978, by J.S. DONALDSON