


T. 17 S. R. 21 E., W.M.

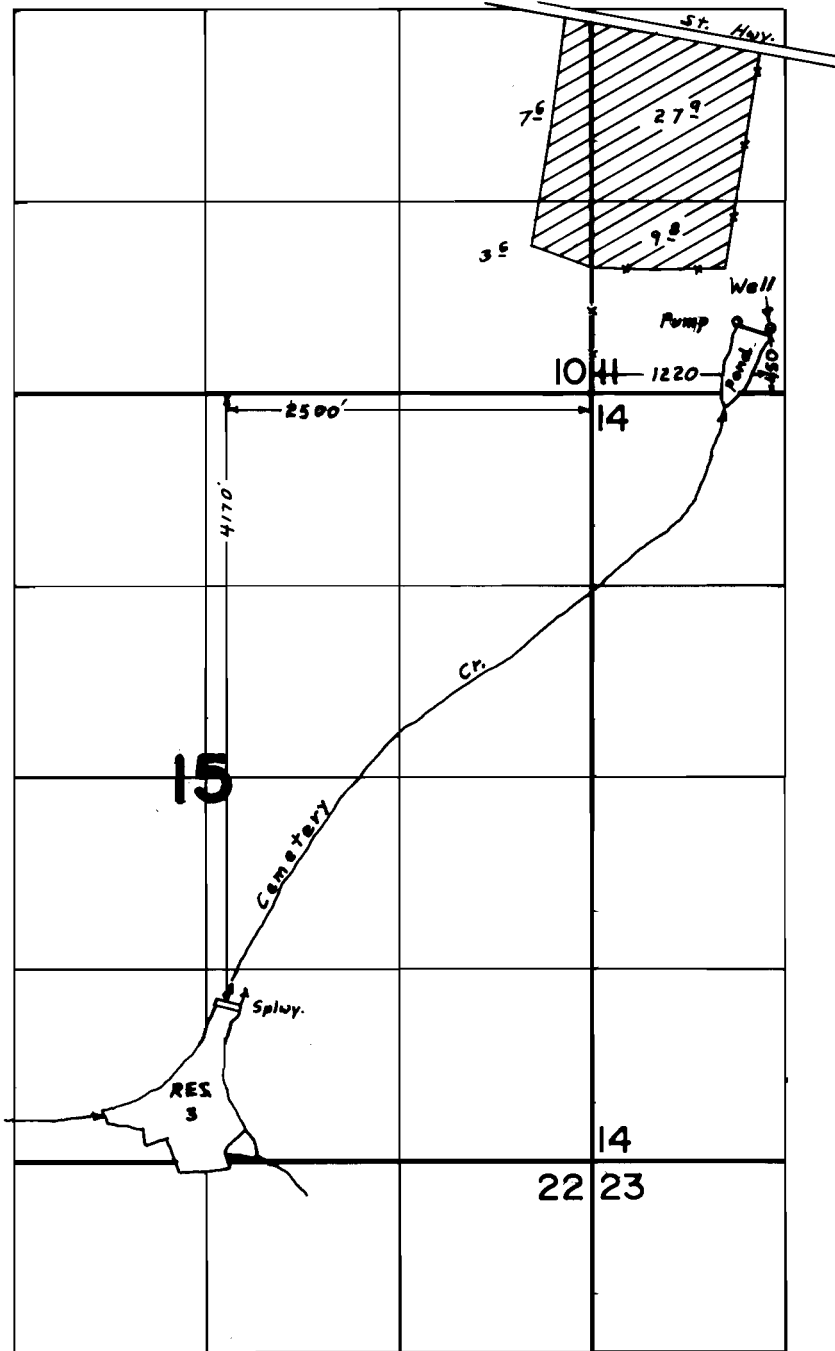

App'l. - 45538 - Primary

App'l. G-7173 - Supplemental

FINAL PROOF SURVEY UNDER

Application No. 45538 R-45537 G-7173 Permit No. 34071 R-5409 G-6699
IN NAME OF

LES SCHWAB TIRE CENTER, INC.

Surveyed JUL 11 1978 by J.S. DONALDSON