


# T. 17 S. R. 2 E., W.M.

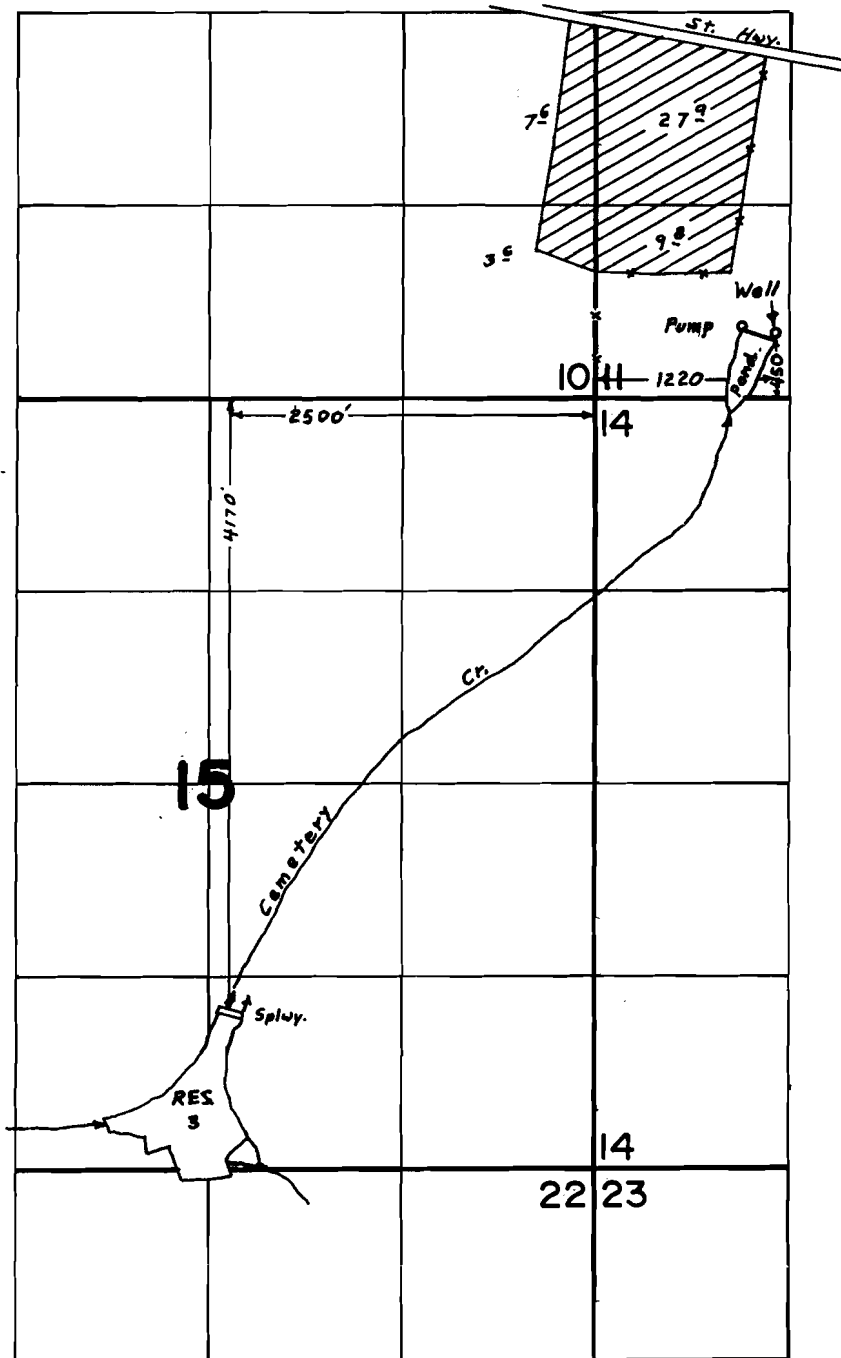

App'l. - 45538 - Primary

App'l. G-7173 - Supplemental

## FINAL PROOF SURVEY UNDER

Application No. 45538 R-45537 Permit No. 34071 R-5409  
G-7173 Permit No. G-6699  
 IN NAME OF

Cert. 52351  
 Cert. 52350  
 Cert. 52354

LES SCHWAB TIRE CENTER, INC.

Surveyed JUL II 1978 by J.S. DONALDSON

G-6669