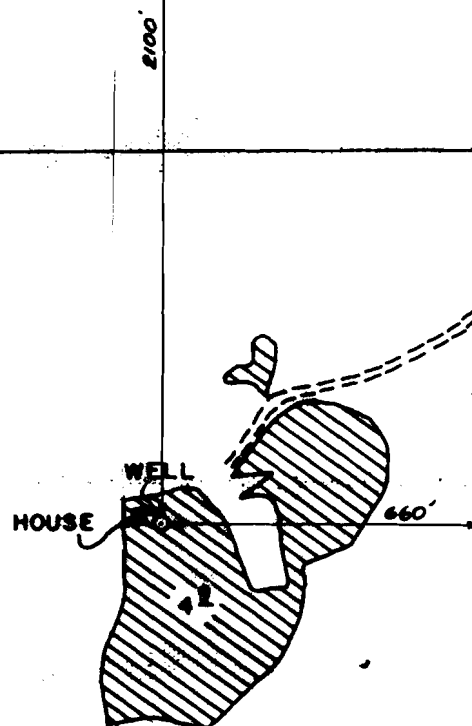


T.14S.R.13E.W.M.

25 30
36 31

36

SCALE: 1" = 400'

FINAL PROOF SURVEY

UNDER

Application No. G-6181. Permit No. G-5858....
IN NAME OF

ROY L. E. & JUNE CLARK.; MICHAEL & CAROL GILBERT

Surveyed .OCT. 6... 1983, by D. PANTHER....

cont. 52355

25858
TS 11-1983A