


**T.32S. R.4W. W.M.**

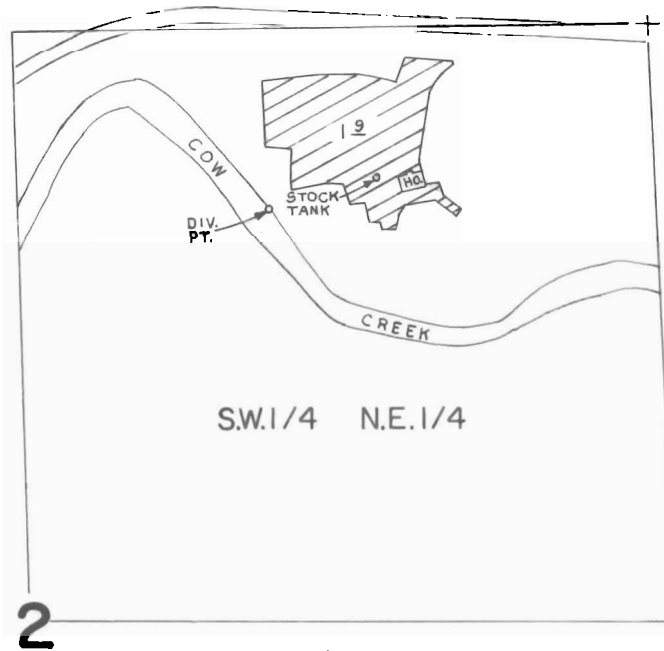

DIV. PT. LOCATED 390'S. & 785'W. FROM N.E. 1/16 CORNER SECTION 2

SCALE : 1" = 400'

**FINAL PROOF SURVEY**  
UNDER

Application No. 49618.. Permit No. 37222.....  
IN NAME OF

.....**MARY L. COOKMAN**.....

Surveyed JUNE 12, 1984, by ...L...CASHION..