


T.23S. R.7W. W.M.

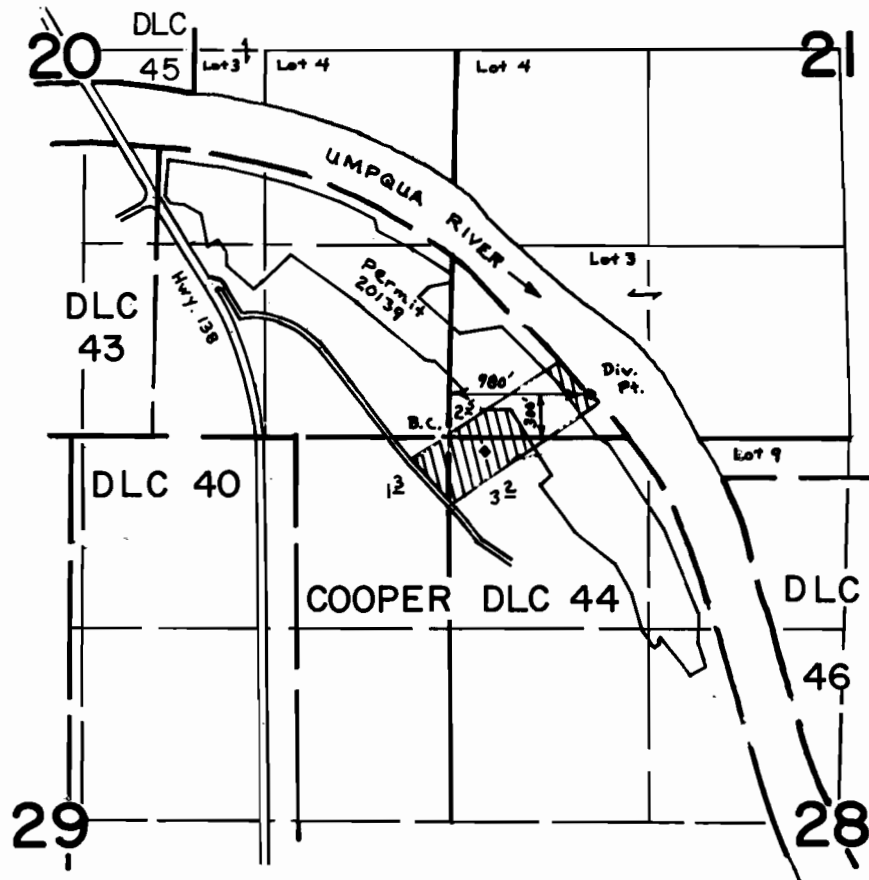

SCALE: 4" = 1 mile

**FINAL PROOF SURVEY
UNDER**

Application No. 52853 Permit No. 39371
IN NAME OF

..... RONALD H. GOURCEY

Surveyed April 12, 1978., by D. Sparks.....