


T.13S.R.30E.W.M.

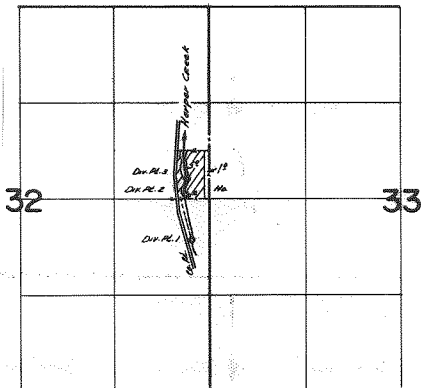

Div. Pt. 1 - 560' S, 240' W
 Div. Pt. 2 - 50' N, 500' W
 Div. Pt. 3 - 270' N, 300' W

All from E & C Co. Sec. 32

FINAL PROOF SURVEY UNDER

Application No. 51273.. Permit No. 38720....
 IN NAME OF

GREG L. BUEL

Surveyed Sept. 15, 1979, by S.C. BROWN.....