


P-43254
52360

T.14S.,R.32E.,W.M.

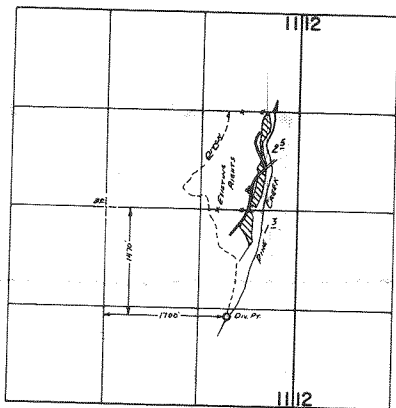

FINAL PROOF SURVEY
UNDER

Application No. 57384, Permit No. 43254.....
IN NAME OF

J. R. CAMPBELL.....

Surveyed July 26, 1983, by R. W. Cattel.....

PT 4-1984 445