


T.32 S., R.3 E., W.M.

T. 33 S., R.2 E., W.M.

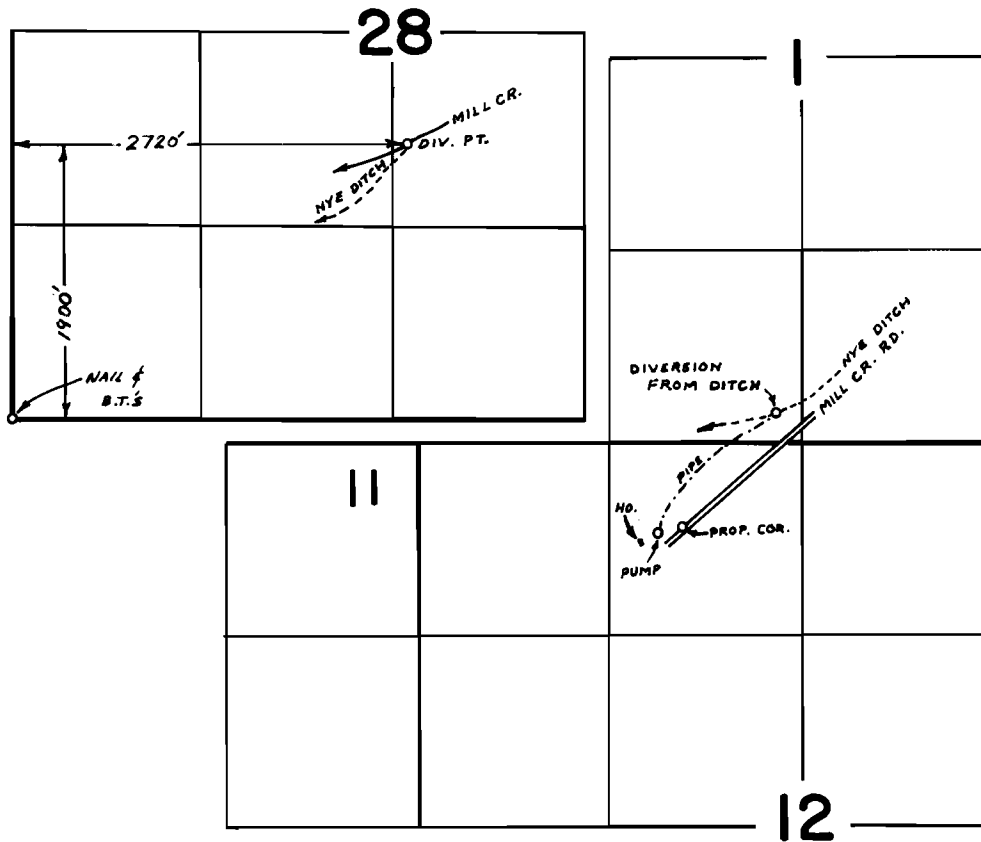

FINAL PROOF SURVEY
UNDER

Application No. 56002 Permit No. 42047
IN NAME OF

RAY B. &/OR LEONA L. WILLIAMS

Surveyed AUG. 28 1978 by B. SUND